

Neshoba Co.
 K 1b
 69
 U565

Test well made @ 1180 (see K1a)

Plugged and Abandoned
 MISSISSIPPI
 BOARD OF WATER COMMISSIONERS
 416 North State Street
 Jackson, Mississippi 39201

WATER WELL DRILLERS LOG

19 Robert E. Ratliff Co. Neshoba
 date well completed firm name county well located

LANDOWNER: South West
Water Ass'n., Inc.
Neshoba Co., Miss.
 (mailing address)

WELL LOCATION:
 sec. 30 T. 10 N. R. 11 E.
 S W N E
 (distance) miles of (direction) (nearest town)

description of formations encountered	from	to
Top Soil	0	20
Sandy Shale	20	110
Shale	110	162
Sand	162	178
Shale	178	268
Hard Shale	268	272
Shale	272	342
Sand	342	388
Shale	388	422
Hard Shale	422	432
Sandy Shale	432	510
Sand	510	530
Shale	530	642
Shale	642	878
Sand	878	888
Sandy Shale	888	950
Sand	950	970
Shale	970	1035
Sand	1035	1045
Shale	1045	1120
Sand	1120	1134
Shale	1134	1154
Sand	1154	1180

WELL PURPOSE:
 (home, irrigation, municipal, industrial)

WELL COMPLETION DATA:

(1) diameter (inches) 8"

(2) total depth (feet) 1180'

(3) static water level (feet) 162 below above top of ground.

(4) casing Steel 341'
 (material) (depth)
8" if telescope see back.
 (size)

(5) screen 10" 341'
 (length) (depth to top)
6" Stainless Steel
 (size) (material)

(6) pump 30 200 GPM
 (HP) (yield gpm)
Electric
 (type power)

(7) electric-log Yes
 (yes or no)
U.S. Geological
 (organization running log)


(8) how well bottom plugged

DRILLERS REMARKS:

SEP 4 1969

If well telescopes please
sketch and show depths.

GROUND LEVEL

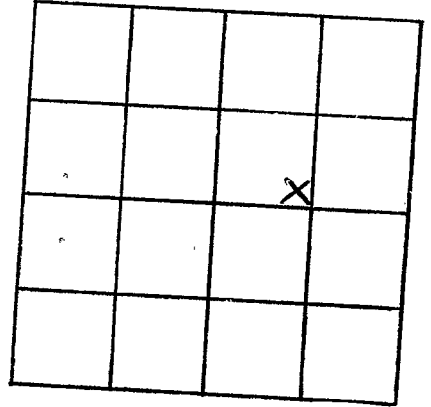

SECTION 30

Please indicate well location X.

ADDITIONAL INFORMATION

If more than one screen,
show locations of each on sketch.