

3 135

Neshoba
R2
4-67 CODED

MISSISSIPPI
BOARD OF WATER COMMISSIONERS
416 North State Street
Jackson, Mississippi 39201

WATER WELL DRILLERS LOG

APRIL 28 1967 OGLETREE DRILLING NESHOBA
date well completed firm name county well located

LANDOWNER: NESHOBA FAIR ASSOC

Description of formations encountered	from	to
RED CLAY	0	10
BLUE CHALK	10	129
GRAY SAND	129	153

(mailing address)

WELL LOCATION:

sec. 19 T 10 N R 11 E
S W
7 miles SOUTH of PHILA.
(distance) (direction) (nearest town)

WELL PURPOSE: MUNICIPAL
(home, irrigation, municipal, industrial)

WELL COMPLETION DATA:

- (1) diameter (inches) 2"
- (2) total depth (feet) 153
- (3) static water level (feet) 40 below top of ground.
- (4) casing GAV. 126
(material) (depth)

(size) if telescope see back.

- (5) screen NONE
(length) (depth to top)

(size) (material)

- (6) pump 1 7
(HP) (yield gpm)

REA
(type power)


- (7) electric log NO
(yes or no)

(organization running log)

- (8) how well bottom plugged OPEN


DRILLERS REMARKS:

CODED

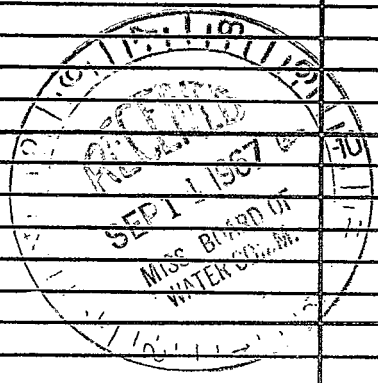

If well telescopes please sketch and show depths.

GROUND LEVEL

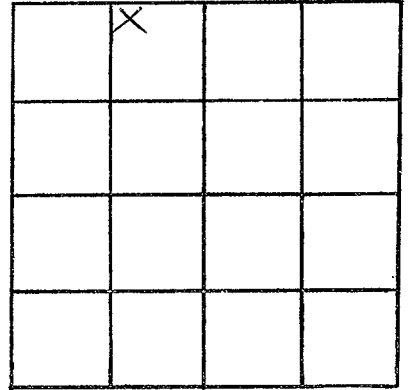

SECTION 19

Please indicate well location X.

ADDITIONAL INFORMATION

If more than one screen,
show locations of each on sketch.