

3 157

Neshoba
K3
4-67

CODED
CODED

MISSISSIPPI
BOARD OF WATER COMMISSIONERS
416 North State Street
Jackson, Mississippi 39201

WATER WELL DRILLERS LOG

APRIL 24 19 67 OGLETREE DRILLING NESHOBA
date well completed firm name county well located

LANDOWNER: NESHOBA COUNTY
FAIR ASSOC.

description of formations encountered	from to	
	from	to
RED CLAY	0	15
BLUE CHALK	15	100
GRAY SAND	100	115
BLUE CHALK	115	225
WHITE SAND	225	273

(mailing address)


WELL LOCATION:
sec. 19 T 10 N R 11 E
S W
7 miles SOUTH of PHILA.
(distance) (direction) (nearest town)

WELL PURPOSE: HOME USE
(home, irrigation, municipal, industrial)

WELL COMPLETION DATA:

- (1) diameter (inches) 4"
- (2) total depth (feet) 273
- (3) static water level (feet) 75 below above top of ground.
- (4) casing Steel, 168, (material) (depth)
2" (size) if telescope see back.
- (5) screen 15, 273-258 (length) (depth to top)
2" STAINLESS STEEL (size) (material)
- (6) pump 1, 27 (HP) (yield gpm)
REA (type power)
- (7) electric log NO (yes or no)
(organization running log)
- (8) how well bottom plugged POINTED

CODED

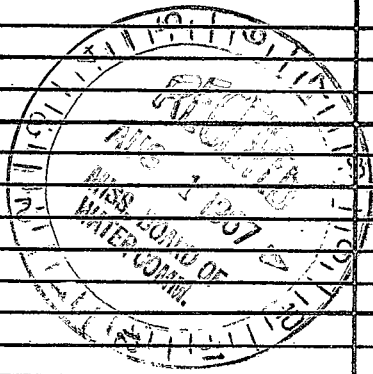

DRILLERS REMARKS:

