

FK5
9-28-61

3 131
CODED

WATER WELL DRILLERS LOG

CODED

Date: 9-28, 1961, Driller: M. L. Ranz, County: Washola
(Name)

(1) Owner of Land:	Description & Color of Materials Sand, Clay, Red Clay, Shell, etc.	Thick- ness Feet	Depth Feet
(Name) Nicholene Fair (Address) Phila. Miss. R #5 13 10 10	Blue to coarse white sand		8 1/2 2 1/2
(2) Location: 1/4, 1/4, Sec. 18, T10R11, 7 1/2 miles west of Phila. (distance) (direction) (Nearest Town)	Blue to white sand 140		1 1/2 148
(3) Topography: (Hilly) (Flat) (Level)			
(4) Purpose of Well: use for fair (Domestic/Irrigation Municipal, Industrial, Other)			


CODED
CODED

Information upon completion of well:

- (1) Diameter 4 inches.
- (2) Total Depth 148 feet.
- (3) Water Level 2.5 feet below top of ground.
- (4) Cased to 97, Size 4 in
- (5) Screen: Size _____, Length _____
- (6) Were any formations sealed against pollution?
 _____ yes, _____ no.

If YES depth of formation _____
Why _____

Drillers Remarks: casing sealed
at 97 ft. casing then
sealed at above 87 ft.

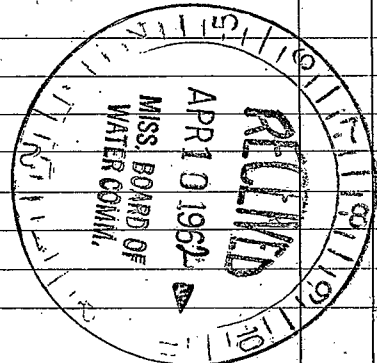

(Use Back Side)

Well No.

[The page contains extremely faint and illegible text, likely bleed-through from the reverse side of the paper. No specific words or phrases can be discerned.]