

WATER WELL DRILLERS LOG

5-131
5-17-61
CODED

Date: 5-17, 1961, Driller: M. E. Huff County: Madison

(1) Owner of Land: Mrs. M. E. Huff
(Name)
1315-5
(Address)

(2) Location: 1/4, 1/4, Sec. 19 T. R.
1/2 miles south of Neshoba
(distance) (direction) (Nearest Town)

(3) Topography: (Hilly) (Flat) (Level)

(4) Purpose of Well: Domestic Irrigation
(Domestic Irrigation, Municipal, Industrial, Other)

Description & Color of Materials Sand, Clay, Red Clay, Shell, etc.	Thickness Feet	Depth Feet
1.0		
1.0		
fact. ground		
on 11/11/61		
created photo 11/11/61		

Information upon completion of well:

- (1) Diameter 2 inches.
- (2) Total Depth 56 feet.
- (3) Water Level 40 feet below top of ground.
- (4) Cased to 51, Size 2 in.
- (5) Screen: Size 1/2", Length 3 ft.
- (6) Were any formations sealed against pollution?


yes, no.

If YES depth of formation

Why

Drillers Remarks:

CODED

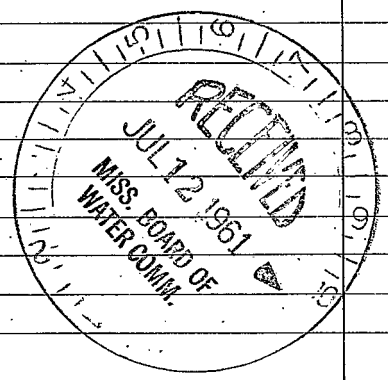

(Use Back Side)

Well No.

