

K 12
11-5-61
CODED

6 131
WATER WELL DRILLERS LOG

Date: 11-5, 1961, Driller: [Signature] County: Neshoba
(Name)


(1) Owner of Land:	Description & Color of Materials Sand, Clay, Red Clay, Shell, etc.	Thick- ness Feet	Depth Feet
Carl's Robinson (Name) Philmora Rd 5	Sand	-	30 ft
4 10 11 (Address)	Clay	-	150 ft
(2) Location: 1/4, 1/4, Sec. 1 T. 1 R. 1	Sand	-	150
5 miles west of Phila. (distance) (direction) (Nearest Town)			
(3) Topography: <input checked="" type="checkbox"/> (Hilly) <input type="checkbox"/> (Flat) <input type="checkbox"/> (Level)			
(4) Purpose of Well: Domestic Irrigation Municipal, Industrial, Other			

Information upon completion of well:

- (1) Diameter: 2 inches.
- (2) Total Depth: 168 feet.
- (3) Water Level: 80 feet below top of ground.
- (4) Cased to: 105' Size
- (5) Screen: Size 60, Length 6
- (6) Were any formations sealed against pollution?
yes, no.

If YES depth of formation _____
Why _____

Drillers Remarks: on highway
2 1/2 miles east of
Phila.

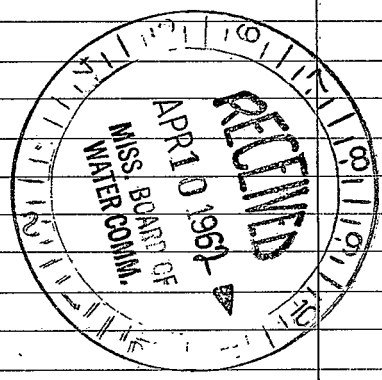

(Use Back Side)

Well No.

