

K 13

CODEP31

7-14-61

WATER WELL DRILLERS LOG

Date: 7-14, 1961, Driller: M. S. ... County: Neshoba

(Name)

(1) Owner of Land: Wood ...

(Name)

Philo ...

(Address)

(2) Location: 1/4, 16 10 11, Sec. T R

6 miles west of Philo

(distance) (direction) (Nearest Town)

(3) Topography: Hilly

(Hilly) (Flat) (Level)

(4) Purpose of Well: Domestic

(Domestic Irrigation Municipal, Industrial, Other)

Description & Color of Materials Sand, Clay, Red Clay, Shell, etc.

Thick-ness Feet

Depth Feet

Blue ... 1 75 ... 2 00

CODED

Information upon completion of well:

(1) Diameter 2 inches.

(2) Total Depth 200 feet.

(3) Water Level 90 feet below top of ground.

(4) Cased to 190, Size

(5) Screen: Size 60%, Length 6

(6) Were any formations sealed against pollution?


yes, no.

If YES depth of formation

Why

Drillers Remarks: ...

... 155 of Philo ...

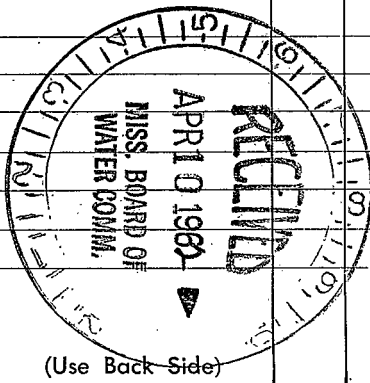

(Use Back Side)

Well No.

