

Neshoba
K15 CODED
4-68

MISSISSIPPI
 BOARD OF WATER COMMISSIONERS
 416 North State Street
 Jackson, Mississippi 39201

WATER WELL DRILLERS LOG

4-15 19 68 OGLETREE DRILLING NESHOBA
 date well completed firm name county well located

LANDOWNER: BETHANY ALEC

NESHOBA, MISS.

(mailing address)

WELL LOCATION:

sec. 35 T10 N R 11 (E)
(S) (W)
7 miles SOUTH of PHILA.
 (distance) (direction) (nearest town)

WELL PURPOSE: HOME USE
 (home, irrigation, municipal, industrial)

WELL COMPLETION DATA:

- (1) diameter (inches) 2"
- (2) total depth (feet) 59
- (3) static water level (feet) 38 (below)
 top of ground. above
- (4) casing GAV. 54
 (material) (depth)
(size) if telescope see back.
- (5) screen 5" 59-54
 (length) (depth to top)
1 1/2 STAINLESS STEEL
 (size) (material)
- (6) pump 3/4 5
 (HP) (yield gpm)
ELEC.
 (type power)
- (7) electric log _____
 (yes or no)

 (organization running log)
- (8) how well bottom plugged POINTED

description of formations encountered

from to

RED CLAY	0	10
RED SAND	10	30
BLUE CHALK	30	35
ROCK	35	45
WHITE SAND	45	59

CODED


AUG 13 1968

MISS. BD. OF
 WATER COMMISSIONERS

DRILLERS REMARKS:

If well telescopes please sketch and show depths.

GROUND LEVEL

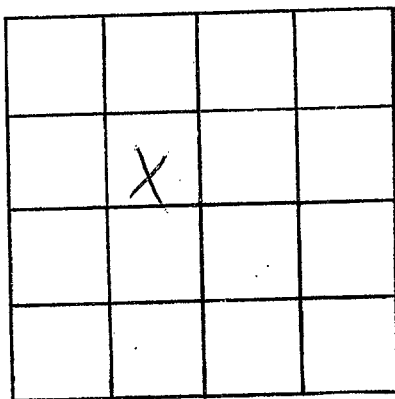

SECTION _____

Please indicate well location X.

ADDITIONAL INFORMATION

If more than one screen,
show locations of each on sketch.