

Neshoba
K16 CODED
5-68

MISSISSIPPI
 BOARD OF WATER COMMISSIONERS
 416 North State Street
 Jackson, Mississippi 39201

WATER WELL DRILLERS LOG

May 27 19*68* *Oglethorpe Drilling* *Neshoba*
 date well completed firm name county well located

LANDOWNER: *Neshoba*
County Fair Ground
Assoc.
 (mailing address)

description of formations encountered	from	to
<i>Red Clay</i>	<i>0</i>	<i>18</i>
<i>Blue Chalk</i>	<i>18</i>	<i>35</i>
<i>Blue Rock</i>	<i>35</i>	<i>110</i>
<i>Blue Chalk</i>	<i>110</i>	<i>230</i>
<i>White Sand</i>	<i>230</i>	<i>278</i>

WELL LOCATION:
 sec. 10 T. 10 S. R. 11 E. W.
6 miles *S.W.* of *Phillips*
 (distance) (direction) (nearest town)

WELL PURPOSE:
 (home, irrigation, municipal, industrial)

WELL COMPLETION DATA:

(1) diameter (inches) 4 1/2
 (2) total depth (feet) 273
 (3) static water level (feet) 23 below above top of ground.
 (4) casing Steel, 168,
 (material) (depth)
4-2 if telescope see back.
 (size)
 (5) screen 20, 273-263
 (length) (depth to top)
2 1/2 Stainless Steel
 (size) (material)
 (6) pump 1 1/2 42 Gal.
 (HP) (yield gpm)
Electric
 (type power)
 (7) electric log _____
 (yes or no)

 (organization running log)
 (8) how well bottom plugged Painted

CODED

AUG 13 1968

MISS. BD. OF
 WATER COMMISSIONERS

DRILLERS REMARKS:

If well telescopes please sketch and show depths.

GROUND LEVEL

4"¹⁶


Cassin

2"¹⁶

Cassin

20 ft
Points

Stainless
Steel

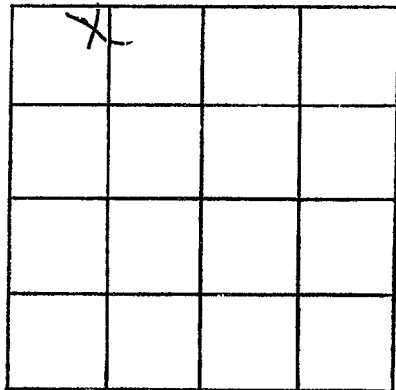

SECTION _____

Please indicate well location X.

ADDITIONAL INFORMATION

If more than one screen,
show locations of each on sketch.