

Neshoba
K 18
5-11-70

MISSISSIPPI
 BOARD OF WATER COMMISSIONERS COPFD
 416 North State Street
 Jackson, Mississippi 39201

WATER WELL DRILLERS LOG

5-11 1970 RR Nicholson Neshoba
 date well completed firm name county well located


LANDOWNER:	description of formations encountered	from	to
<u>Ray Farmer</u>	<u>Chalk & sand</u>	<u>0</u>	<u>34</u>
<u>Phila.</u>	<u>blue dirt</u>	<u>34</u>	<u>195</u>
<u>Miss.</u>	<u>Shelly dirt</u>	<u>195</u>	<u>215</u>
(mailing address)	<u>blue dirt</u>	<u>215</u>	<u>295</u>
WELL LOCATION:	<u>water sand</u>	<u>295</u>	<u>314</u>
sec. <u>7</u> T <u>10</u> R <u>11</u>			
<u>3 1/2</u> miles <u>South</u> of <u>Phila.</u>			
(distance) (direction) (nearest town)			
WELL PURPOSE: <u>home</u>			
(home, irrigation, municipal, industrial)			
WELL COMPLETION DATA:			
(1) diameter (inches) <u>4 1/4</u>			
(2) total depth (feet) <u>314</u>			
(3) static water level (feet) <u>130</u> below top of ground.			
(4) casing <u>galv.</u> <u>309</u>			
(material) (depth)			
<u>2"</u> if telescope see back.			
(size)			
(5) screen <u>5'</u> <u>314</u>			
(length) (depth to top)			
<u>1/4</u> <u>Steel</u>			
(size) (material)			
(6) pump <u>1/2</u> <u>5</u>			
(HP) (yield gpm)			
<u>elect.</u>			
(type power)			
(7) electric log <u>NO</u>			
(yes or no)			
(organization running log)			
(8) how well bottom plugged <u>Screen</u>			
DRILLERS REMARKS:			

III 24

MISS. BD. OF WATER COMM.

If well telescopes please sketch and show depths.

GROUND LEVEL

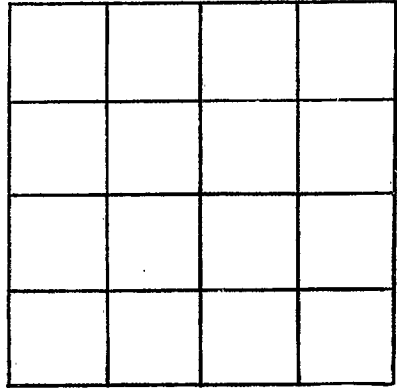

SECTION _____

Please indicate well location X.

ADDITIONAL INFORMATION

If more than one screen, show locations of each on sketch.