

K206

CODED WATER WELL DRILLERS LOG

Date: July 17 1964, Driller: M G Ray County Neshoba
7-17-64 (Name)

(1) Owner of Land: Richard Smith
(Name)
Neshoba Miss Rth

(Address)
11 10 11

(2) Location: 1/4, 1/4, Sec. T. R.,
5 1/2 miles South of Phila.
(distance) (direction) (Nearest Town)

(3) Topography: [check] (Hilly) (Flat) (Level)

(4) Purpose of Well: Domestic
(Domestic Irrigation
Municipal, Industrial, Other)

Description & Color of Materials
Sand, Clay, Red Clay, Shell, etc.

Thick-
ness
Feet

Depth
Feet

Sand all way
from 210 ft
Dry Sand to 200 ft
red clay to 42 ft

Information upon completion of well:

(1) Diameter 2 inches.

(2) Total Depth 124 feet.

(3) Water Level 60 feet below top of ground.

(4) Cased to 120, Size 2 in.

(5) Screen: Size 60, Length 6 ft.

(6) Were any formations sealed against pollution?


yes, no.

If YES depth of formation

Why

Drillers Remarks:

CODED
CODED

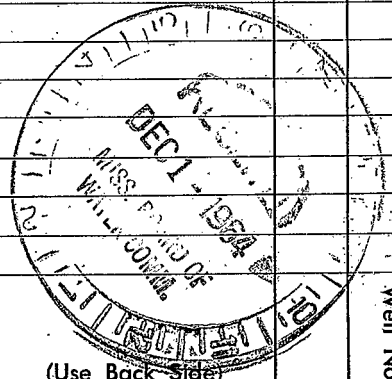

(Use Back Side)

Well No.

