

NESHOMA

MISSISSIPPI BOARD OF WATER COMMISSIONERS

K21

6 13T

11-12-61

CODED WATER WELL DRILLERS LOG

Date: 11-12, 1961, Driller: M. G. Ray County Neshoba
(Name)

(1) Owner of Land: Howard Eldridge
(Name)

Philamiss A#4
(Address)

(2) Location: 1/4, 1/4, Sec. 25 10 11, T. R
9 miles South of Philadelp
(distance) (direction) (Nearest Town)

(3) Topography: (Hilly) (Flat) (Level)

(4) Purpose of Well: Domestic
(Domestic Irrigation, Municipal, Industrial, Other)

Description & Color of Materials
Sand, Clay, Red Clay, Shell, etc.

Red clay to 25 ft
25 ft
25 ft
Red sand, 2
Red clay to 110 ft
course of flow of sand at 110 ft

Thick-ness Feet

Depth Feet

Information upon completion of well:

(1) Diameter 2 inches.

(2) Total Depth 112 feet.

(3) Water Level 62 feet below top of ground.

(4) Cased to 105, Size 2 in

(5) Screen: Size 60, Length 6 ft

(6) Were any formations sealed against pollution?

no


If YES depth of formation _____

Why _____

Drillers Remarks:

near mt Olive Church

CODED

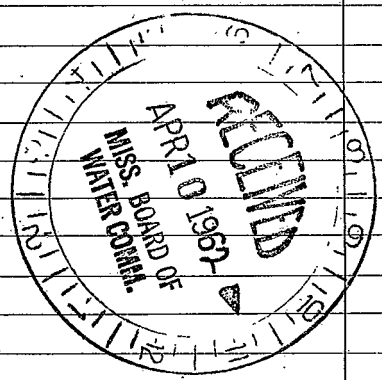

(Use Back Side)

Well No.

