

NESHOBA

K22

8-1-73

MISSISSIPPI BOARD OF WATER COMMISSIONERS
416 North State Street
Jackson, Mississippi 39201

CODED

WATER WELL DRILLERS LOG

8/1/73 19
date well completed

F. D. Cannon NESHOBA Co.
firm name county well located

LANDOWNER: R. G. Wilcher
P.O. Box 110
Miss.
(mailing address)

description of formations encountered	from	to
Red clay	0	15
Chalk	15	23
Coarse sand	23	30

WELL LOCATION:
sec. 21 ^N 10 ^W 11
3 miles S of Williamsville
(distance) (direction) (nearest town)

WELL PURPOSE:
 home irrigation, municipal, industrial

- WELL COMPLETION DATA:
- (1) diameter (inches) 2"
 - (2) total depth (feet) 30
 - (3) static water level (feet) 10 below above top of ground.
 - (4) casing 2" P.V.C. 25' (material) (depth)
2" (size) if telescope see back.
 - (5) screen 2" P.V.C. 25' (length) (depth to top)
2" (size) P.V.C. (material)
 - (6) pump 1/2 (HP) 110 gal (yield gpm)
Elec. (type power)
 - (7) electric log 40 (yes or no)
 - (organization running log)
 - (8) how well bottom plugged Clay


CODED

DRILLERS REMARKS:

AUG 6 1973

If well telescopes please sketch and show depths.

GROUND LEVEL

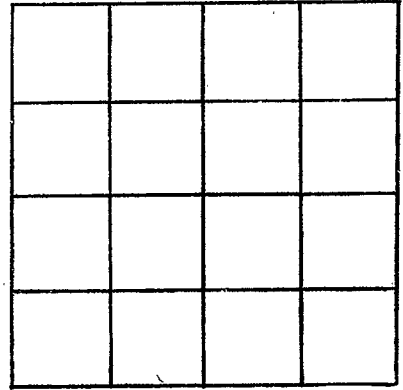

SECTION _____

Please indicate well location X.

ADDITIONAL INFORMATION

If more than one screen, show locations of each on sketch.