

K24 CODED
11-10-63

6 137

WATER WELL DRILLERS LOG

Date: 11-10, 1963, Driller: W L Ray County Neshoba
(Name)

(1) Owner of Land: Charles Bonds
(Name)
Phike miss ri 2
(Address)

(2) Location: $\frac{1}{4}$, 35 10 11 Sec. 11 T 11 R
15 miles East, of Phike
(distance) (direction) (Nearest Town)

(3) Topography: V
(Hilly) (Flat) (Level)

(4) Purpose of Well: Domestic
(Domestic Irrigation
Municipal, Industrial, Other)


Description & Color of Materials Sand, Clay, Red Clay, Shell, etc.	Thick- ness Feet	Dept Fee
<u>Blue Clay to</u>		
<u>105 ft</u>		
<u>Gray Sand</u>		
<u>120-747 ft</u>		

Information upon completion of well:

- (1) Diameter 2 inches.
- (2) Total Depth 147 feet.
- (3) Water Level 48 feet below top of ground.
- (4) Cased to 73, Size 2 in.
- (5) Screen: Size None Length _____.
- (6) Were any formations sealed against pollution?
_____ yes, ✓ no.

If YES depth of formation _____
Why _____

Drillers Remarks: _____

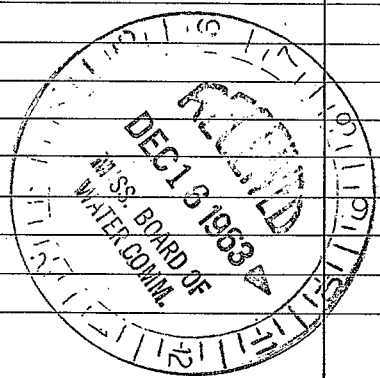

(Use Back Side)

Well No.

