

NEHOBA  
K 26  
6-4-62

WATER WELL DRILLERS LOG

CODED

Date: 6-4, 1962 Driller: R R Nicholas county Nehoba

PR-60 Ezell Denson (Name)

(1) Owner of Land: U.S. Govt (Name)  
Phila. Miss. (Address)

(2) Location: 5 10 11 1/4, 1/4, Sec. T R

5 miles west of Phila. (distance) (direction) (Nearest Town)

(3) Topography: Hilly (Hilly) (Flat) (Level)

(4) Purpose of Well: Domestic (Domestic Irrigation Municipal, Industrial, Other)

Description & Color of Materials Sand, Clay, Red Clay, Shell, etc.	Thick- ness Feet	Depth Feet
Sand & Clay	1	15
Rock	15	75
blue dirt	75	85
good coarse sand	85	95

CODED

Information upon completion of well:

(1) Diameter: 4 1/2 inches.

(2) Total Depth: 95 feet.

(3) Water Level: 75 feet below top of ground.


(4) Cased to: Point, Size 2"

(5) Screen: Size 2", Length 5"

(6) Were any formations sealed against pollution?  
yes, no.

If YES depth of formation  
Why

Drillers Remarks: Good Well  
Cylinder is 84 ft  
from top of ground

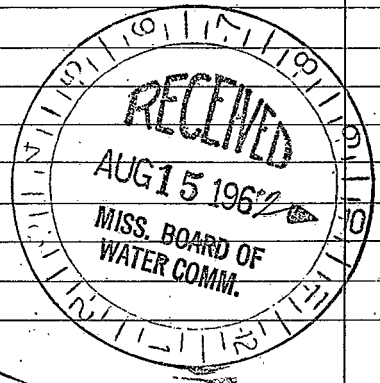

(Use Back Side)

Well No.

Handwritten notes at the top of the page, including the word "SOLUTION" and other illegible scribbles.

Handwritten notes in the middle section, appearing as a list or series of points.

Handwritten notes in the lower middle section, continuing the list or points.

Handwritten notes in the lower section, including some larger, more distinct markings.

Handwritten notes at the bottom of the page, including the word "SOLUTION" and other illegible scribbles.