

NESHOPA

K 27

12-18-70

MISSISSIPPI BOARD OF WATER COMMISSIONERS
416 North State Street
Jackson, Mississippi 39201

CODED

WATER WELL DRILLERS LOG

12-18

date well completed

1970 BBR Nicholson Neshoba

firm name

county well located

LANDOWNER: Bud Breedland

Shula, Miss -
(mailing address)

Description of formations encountered

from to

Clay & sand	0	70
Shell & chalk	70	45
water sand	45	54

WELL LOCATION:

sec. 19 T. 10 N. R. 11 E
8 miles West of Shula
(distance) (direction) (nearest town)

WELL PURPOSE: home
(home, irrigation, municipal, industrial)

WELL COMPLETION DATA:

- (1) diameter (inches) 4 1/4
- (2) total depth (feet) 54
- (3) static water level (feet) 45 below top of ground
- (4) casing Galv. 49' (material) (depth)
- 1" if telescope see back. (size)
- (5) screen 5' 54" (length) (depth to top)
- 1/4" Steel (size) (material)
- (6) pump 1 4 (HP) (yield gpm)
- Elect. (type power)
- (7) electric log no (yes or no)

CODED

(organization running log)

(8) how well bottom plugged Screen


MAY 3 1970

DRILLERS REMARKS:

MISS. BD. OF WATER COMM.

If well telescopes please sketch and show depths.

GROUND LEVEL

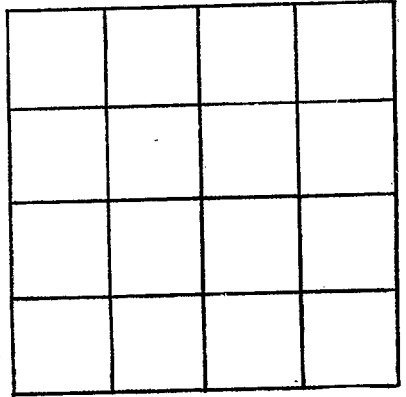

SECTION _____

Please indicate well location X.

ADDITIONAL INFORMATION

If more than one screen, show locations of each on sketch.