

NESHOPA

K 28

2-16-71

MISSISSIPPI BOARD OF WATER COMMISSIONERS
416 North State Street
Jackson, Mississippi 39201

CODED

WATER WELL DRILLERS LOG

2-16

date well completed

21 *Bob Y. Nicholson* Neshoba

firm name

county well located

LANDOWNER: *Ways Barkam*

Shila

Miss -
(mailing address)

description of fomations encountered

from

to

| | | |
|----------------------------|------------|------------|
| <i>Clay</i> | <i>0</i> | <i>16</i> |
| <i>Blue dirt</i> | <i>16</i> | <i>110</i> |
| <i>Rock</i> | <i>110</i> | <i>117</i> |
| <i>blue shell</i> | <i>117</i> | <i>130</i> |
| <i>Wet sand & dirt</i> | <i>130</i> | <i>170</i> |
| <i>Water sand</i> | <i>170</i> | <i>188</i> |

WELL LOCATION:

sec. 22 T. 10 N. R. 11 E

10 miles *West* of *Shila*
(distance) (direction) (nearest town)

WELL PURPOSE: *home*
(home, irrigation, municipal, industrial)

WELL COMPLETION DATA:

- (1) diameter (inches) *4 1/4*
- (2) total depth (feet) *188*
- (3) static water level (feet) *100* below top of ground.
- (4) casing *galv.* (*178*)
(material) (depth)
2"
(size) if telescope see back.
- (5) screen *10'* (*188*)
(length) (depth to top)
1 1/4" (*steel*)
(size) (material)
- (6) pump *1/2* (*4*)
(HP) (yield gpm)
Electric
(type power)
- (7) electric log *no*
(yes or no)

(organization running log)

(8) how well bottom plugged *Screen*

DRILLERS REMARKS:


CODED

MAY 3 - 1971

MISS. Bd. of WATER COMMISSIONERS

If well telescopes please sketch and show depths.

GROUND LEVEL

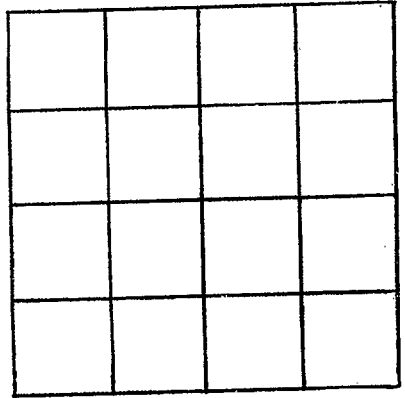

SECTION _____

Please indicate well location X.

ADDITIONAL INFORMATION

If more than one screen, show locations of each on sketch.