

NESHOBA

R29

3-22-71

MISSISSIPPI  
 BOARD OF WATER COMMISSIONERS  
 416 North State Street  
 Jackson, Mississippi 39201

**CODED**

WATER WELL DRILLERS LOG

3-22

date well completed

1971 R B Nicholson Neshoba

firm name

county well located

LANDOWNER: Clyde Resbhorn

Shila  
 W R R  
 (mailing address)

description of formations encountered

from to

Clay & Chalk	0	30
blue loam	30	180
Water Sand	180	210

WELL LOCATION:

sec 4 T 10 N R 11 E  
 3 miles west of Shila  
 (distance) (direction) (nearest town)

WELL PURPOSE: home  
 (home, irrigation, municipal, industrial)

WELL COMPLETION DATA:

- (1) diameter (inches) 4 1/4
- (2) total depth (feet) 210
- (3) static water level (feet) 35 below above top of ground.
- (4) casing Galv. 140  
 (material) (depth)  
2"  
 (size) if telescope see back.
- (5) screen X X  
 (length) (depth to top)  
X X  
 (size) (material)
- (6) pump 1 12  
 (HP) (yield gpm)  
Elect.  
 (type power)
- (7) electric log no  
 (yes or no)

**CODED**

(organization running log)

(8) how well bottom plugged open


MAY 3 - 1971

DRILLERS REMARKS:

MISS. DD-05  
 WATER COM. 4.

If well telescopes please sketch and show depths.

GROUND LEVEL

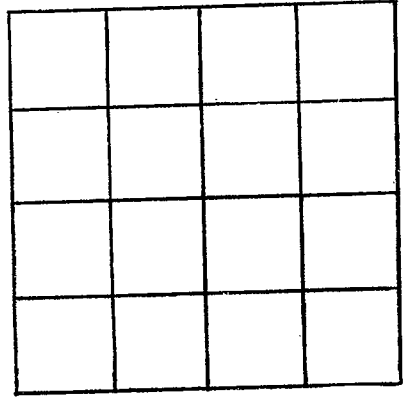

SECTION \_\_\_\_\_

Please indicate well location X.

ADDITIONAL INFORMATION

If more than one screen, show locations of each on sketch.