

NESHOBIA

K30

3-24-71

MISSISSIPPI
 BOARD OF WATER COMMISSIONERS
 416 North State Street
 Jackson, Mississippi 39201

CODED

WATER WELL DRILLERS LOG

3-24

date well completed

1971

R.R. Nicholson Neshoba

firm name

county well located

LANDOWNER: *Luther Bresland*

Phila.

Miss.

(mailing address)

description of formations encountered

from

to

Clay

0

5

Mix chert sand

5

13

Water sand

13

18

WELL LOCATION:

sec. *34* T *10* N R *11* E

11 miles *South* of *Phila.*
(distance) (direction) (nearest town)

WELL PURPOSE:

home
(home, irrigation, municipal, industrial)

WELL COMPLETION DATA:

(1) diameter (inches) *4 1/4*

(2) total depth (feet) *12'*

(3) static water level (feet) *8* below above top of ground.

(4) casing *Galv.* *13'*
(material) (depth)

2"
(size) If telescope see back.

(5) screen *5'* *18'*
(length) (depth to top)

1 1/4" *Steel*
(size) (material)

(6) pump *1/2* *7*
(HP) (yield gpm)

Elect.
(type power)

(7) electric log *no*
(yes or no)

(organization running log)

(8) how well bottom plugged *Screen*

DRILLERS REMARKS:


CODED

MAY 3 1971

MISS. Bd. OF
WATER COM.

If well telescopes please sketch and show depths.

GROUND LEVEL

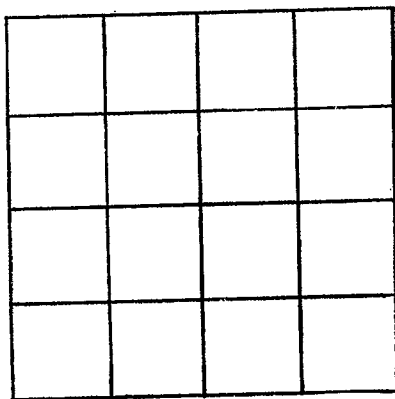

SECTION _____

Please indicate well location X.

ADDITIONAL INFORMATION

If more than one screen, show locations of each on sketch.