

Neshoba
K33
7-5-71

MISSISSIPPI
BOARD OF WATER COMMISSIONERS
416 North State Street
Jackson, Mississippi 39201

WATER WELL DRILLERS LOG

CODED

7-5 1971 BB Nicholson Neshoba
date well completed firm name county well located

LANDOWNER: Choice State
Shila
Miss, RT9
(mailing address)

description of formations encountered	from	to
Clay	0	9
Clay & sand	9	24
Chalk & dirt	24	65
Chalk sand	65	82
water sand	82	95

WELL LOCATION:
sec 23 T 10 N R 11 E
9 miles West of Shila
(distance) (direction) (nearest town)

WELL PURPOSE: home
(home, irrigation, municipal, industrial)

- WELL COMPLETION DATA:
- (1) diameter (inches) 4 1/4"
 - (2) total depth (feet) 95
 - (3) static water level (feet) 50 below above top of ground.
 - (4) casing Gal. 95 (material), (depth)
7" (size) if telescope see back.
 - (5) screen 5' 95' (length) (depth to top)
1 1/4" (size) steel (material)
 - (6) pump 1 9 (HP) (yield gpm)
Elect (type power)
 - (7) electric log No (yes or no)
 - (8) how well bottom plugged _____
(organization running log)


CODED

DRILLERS REMARKS:

NOV 12 1971

If well telescopes please sketch and show depths.

GROUND LEVEL

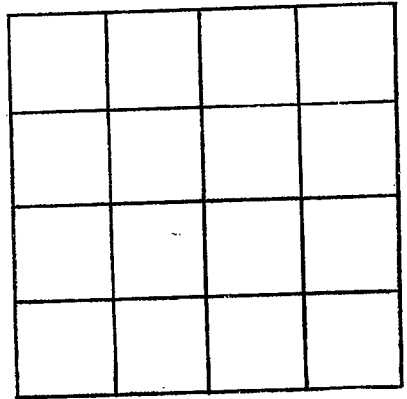

SECTION _____

Please indicate well location X.

ADDITIONAL INFORMATION

If more than one screen, show locations of each on sketch.