

MISSISSIPPI
 BOARD OF WATER COMMISSIONERS
 416 North State Street
 Jackson, Mississippi 39201

CODED

WATER WELL DRILLERS LOG

8-27
 date well completed

1971 P R Nicholson
 firm name

Neeshoba
 county well located

LANDOWNER: James Reynolds
Shila
Miss
 (mailing address)

description of formations encountered	from	to
Clay	0	12
miry dirt	12	40
sand & dirt	40	60
water sand	60	72

WELL LOCATION:
 sec 26 T 10 N R 11 E
7 miles South Shila
 (distance) (direction) (nearest town)

WELL PURPOSE: home
 (home, irrigation, municipal, industrial)

- WELL COMPLETION DATA:
- (1) diameter (inches) 4 1/4"
 - (2) total depth (feet) 79'
 - (3) static water level (feet) 51' below top of ground.
 - (4) casing Bad. 67'
 (material) (depth)
2" If telescope see back.
 (size)
 - (5) screen 5' 72'
 (length) (depth to top)
1 1/4" Steel
 (size) (material)
 - (6) pump 1 8
 (HP) (yield gpm)
Elect.
 (type power)
 - (7) electric log NO
 (yes or no)

CODED


(organization running log)

(8) how well bottom plugged

DRILLERS REMARKS:

If well telescopes please sketch and show depths.

GROUND LEVEL

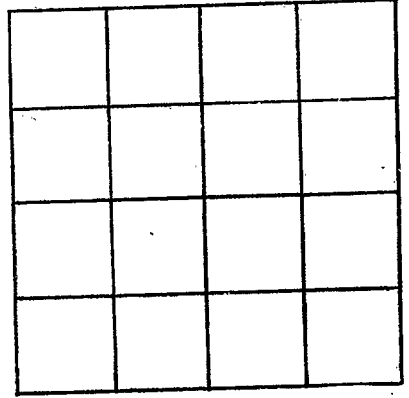

SECTION _____

Please indicate well location X.

ADDITIONAL INFORMATION

If more than one screen, show locations of each on sketch.