

Neshoba
K 35
11-27-71

CODED
MISSISSIPPI

BOARD OF WATER COMMISSIONERS
416 North State Street
Jackson, Mississippi 39201

FEB 18 1972

MISS. BD. OF

WATER WELL DRILLERS LOG

11-27-71 date well completed Beech Smith firm name Neshoba county well located

LANDOWNER:
Bill Marshall
Phila Miss
(mailing address)

description of formations encountered	from	to
red clay	0	48
Blue chalk	48	90
Grey sand	90	120

WELL LOCATION:
sec. 1 T. 10 N S R. 11 E W
4 miles NW of Phila
(distance) (direction) (nearest town)

WELL PURPOSE: home
(home, irrigation, municipal, industrial)

WELL COMPLETION DATA:

(1) diameter (inches) 2"

(2) total depth (feet) 120'

(3) static water level (feet) 45' below top of ground.

(4) casing galv., 115' (material) (depth)
2" if telescope see back. (size)

(5) screen 5, 115' (length) (depth to top)
008, stainless steel (size) (material)

(6) pump 1/2 HP 6 (HP) (yield gpm)
elec. (type power)

(7) electric log no (yes or no)

(organization running log)


(8) how well bottom plugged back wash valve

CODED

DRILLERS REMARKS:

If well telescopes please sketch and show depths.

GROUND LEVEL

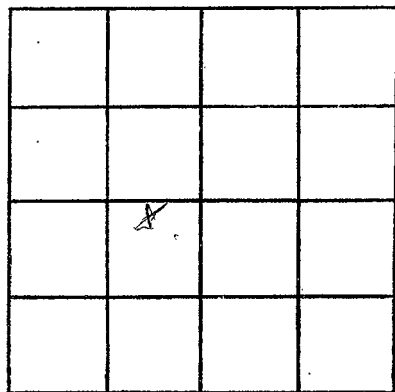

SECTION 1

Please indicate well location X.

ADDITIONAL INFORMATION

If more than one screen, show locations of each on sketch.