

**R 40**  
**NESHOPA**  
**7-7-73**

MISSISSIPPI  
 BOARD OF WATER COMMISSIONERS  
 416 North State Street  
 Jackson, Mississippi 39201

**CODED**

**WATER WELL DRILLERS LOG**

7-7 date well completed    1973 Beck Smith firm name    Neshoba county well located

**LANDOWNER:**  
Billy Wheiment  
Phila. miss  
 (mailing address)

description of formations encountered	from	to
	<u>red clay</u>	<u>0</u>
<u>blue chalk</u>	<u>21</u>	<u>45</u>
<u>gray sand</u>	<u>45</u>	<u>60</u>

**WELL LOCATION:**  
 sec. 1 T 10 N R 11 E  
3 miles South of Phila.  
 (distance) (direction) (nearest town)

**WELL PURPOSE:** home  
 (home, irrigation, municipal, industrial)

**CODED**


- WELL COMPLETION DATA:**
- (1) diameter (inches) 2"
  - (2) total depth (feet) 60'
  - (3) static water level (feet) 30' <sup>below</sup> top of ground.
  - (4) casing galv. (material) 55' (depth)  
2" (size) if telescope see back.
  - (5) screen 5' (length) 55' (depth to top)  
008 (size) stainless steel (material)
  - (6) pump 1 (HP) - (yield gpm)  
elec (type power)
  - (7) electric log - (yes or no)  
 (organization running log)
  - (8) how well bottom plugged back  
wash valve

**DRILLERS REMARKS:**

**AUG 23 1973**

If well telescopes please sketch and show depths.

GROUND LEVEL

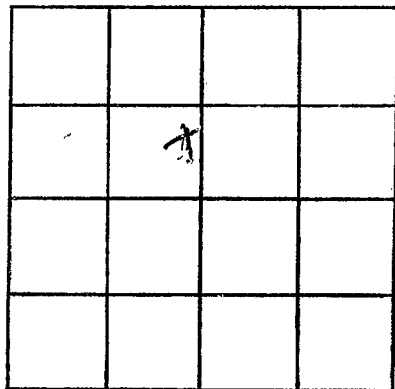

SECTION 1

Please indicate well location X.

ADDITIONAL INFORMATION

If more than one screen,  
show locations of each on sketch.