

NESHOBA
K 41
12-1-73

MISSISSIPPI
BOARD OF WATER COMMISSIONERS
 416 North State Street
 Jackson, Mississippi 39201

WATER WELL DRILLERS LOG

12-1-73 19 73 F.D. Conway NESHOBA
 date well completed firm name county well located

LANDOWNER: William McKern
Philadelphia
Miss
 (mailing address)

description of formations encountered	from	to
Red Clay	0	35
Sandstone	35	60
Shale	60	70
Blue Slate	70	140
Sand	140	160
Black Dirt	160	170

WELL LOCATION:
 sec. 8 T 10 N 5 R 11 E W
3 miles E of Williamsville
 (distance) (direction) (nearest town)

WELL PURPOSE:
 home irrigation, municipal, industrial


- WELL COMPLETION DATA:
- diameter (inches) 2 1/2
 - total depth (feet) 166'
 - static water level (feet) 100 below top of ground.
 - casing 2" P.C.P. - 160'
 (material) (depth)
2 if telescope see back.
 (size)
 - screen 2" P.C.P. - 155'
 (length) (depth to top)
2" P.C.P. - 12'
 (size) (material)
 - pump 2 120
 (HP) (yield gpm)
E. Van.
 (type power)
 - electric log NO
 (yes or no)
Coop
 (organization running log)
 - how well bottom plugged _____

DRILLERS REMARKS:

NOV - 4 1973
 MISSISSIPPI
 WATER

If well telescopes please sketch and show depths.

GROUND LEVEL

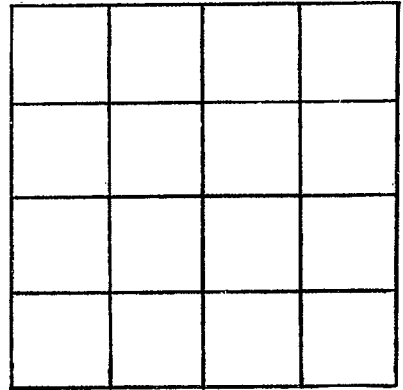

SECTION _____

Please indicate well location X.

ADDITIONAL INFORMATION

If more than one screen, show locations of each on sketch.