

NESHOBA
K 42
11-28-73

MISSISSIPPI
 BOARD OF WATER COMMISSIONERS
 416 North State Street
 Jackson, Mississippi 39201

WATER WELL DRILLERS LOG

11-28-73 19 F.D. Conway NESHOBA
 date well completed firm name county well located

LANDOWNER: Jessie Cockrell Jr

| description of formations encountered | from to | |
|---------------------------------------|-----------|-----------|
| | feet | feet |
| <u>Philadelphia mass</u> | <u>0</u> | <u>20</u> |
| <u>Red Clay</u> | <u>20</u> | <u>35</u> |
| <u>Sand and chert</u> | <u>35</u> | <u>56</u> |

(mailing address)

WELL LOCATION:
 sec. 8 11 E
3 miles E of Williamsville
 (distance) (direction) (nearest town)

WELL PURPOSE:
 home irrigation, municipal, industrial


- WELL COMPLETION DATA:
- diameter (inches) 2"
 - total depth (feet) 56
 - static water level (feet) 30 below above top of ground.
 - casing 2" pvc 50'
 (material) (depth)
2" if telescope see back.
 (size)
 - screen 2" pvc 50'
 (length) (depth to top)
2" pvc 6'
 (size) (material)
 - pump 1 110
 (HP) (yield gpm)
Edco
 (type power)
 - electric log no
 (yes or no)
Cap
 (organization running log)
 - how well bottom plugged _____

DEC - 5 1973
 MISS. BD. OF WATER COMMISSIONERS

DRILLERS REMARKS:

If well telescopes please sketch and show depths.

GROUND LEVEL

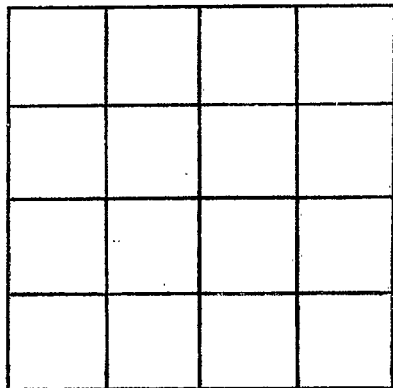

SECTION _____

Please indicate well location X.

ADDITIONAL INFORMATION

If more than one screen, show locations of each on sketch.