

NESHOPA

K43

4-16-75

MISSISSIPPI BOARD OF WATER COMMISSIONERS CODED 416 North State Street Jackson, Mississippi 39201

WATER WELL DRILLERS LOG

4-16-1975 date well completed

firm name

county well located

LANDOWNER

description of formations encountered

from

to

(mailing address)

WELL LOCATION:

sec 26 T 10 N R 11 E S W

7 miles south of Philadelphia (distance) (direction) (nearest town)

WELL PURPOSE:

(home, irrigation, municipal, industrial)

WELL COMPLETION DATA:

- (1) diameter (inches) 2
(2) total depth (feet) 19.5
(3) static water level (feet) 63 below top of ground.
(4) casing (material) (depth) 290

- (5) screen (length) (depth to top) (size) (material)

- (6) pump (HP) (yield, gpm) (type power)

- (7) electric log (yes or no) (organization running log)

- (8) how well bottom plugged

DRILLERS REMARKS:

Handwritten log entries: Blue Clay, Water Sand, with depth markers 112, 180, 175.

CODED



RECEIVED stamp

APR 29 1975

MISS. BD. OF WATER COMMISSIONERS

If well telescopes please sketch and show depths.

2011
GROUND LEVEL

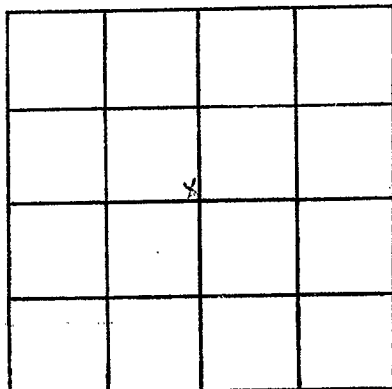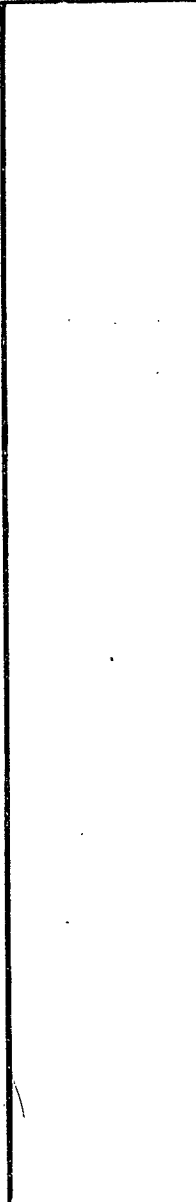

SECTION _____

Please indicate well location X.

ADDITIONAL INFORMATION

If more than one screen, show locations of each on sketch.