

NESHOBA
K45
6-26-74

MISSISSIPPI
BOARD OF WATER COMMISSIONERS
416 North State Street
Jackson, Mississippi 39201

CODED

WATER WELL DRILLERS LOG

6-26-74 date well completed 19 ¹⁶⁰ Williamson Drilling Co firm name Neshoba county well located

LANDOWNER: <u>Casper McJannet</u>	description of formations encountered	from	to
<u>Plot 4</u>	<u>red clay</u>	<u>0</u>	<u>8</u>
<u>Philadelphia Ms.</u> (mailing address)	<u>red sand</u>	<u>8</u>	<u>34</u>
	<u>blue clay</u>	<u>34</u>	<u>66</u>
	<u>sand</u>	<u>66</u>	<u>81</u>

WELL LOCATION:
sec. 12 T. 10 N. R. 11 E
S
2 miles south of Philadelphia
(distance) (direction) (nearest town)

WELL PURPOSE: Home
(home, irrigation, municipal, industrial)


- WELL COMPLETION DATA:
- (1) diameter (inches) 2
 - (2) total depth (feet) 81
 - (3) static water level (feet) 60 below top of ground.
 - (4) casing PVC, 71
(material) (depth)
9"
(size) if telescope see back.
 - (5) screen 10', 71
(length) (depth to top)
10, PVC
(size) (material)
 - (6) pump 1, 5
(HP) (yield gpm)
Elect
(type power)
 - (7) electric log No
(yes or no)
No
(organization running log)
 - (8) how well bottom plugged Cap

DRILLERS REMARKS:

RECEIVED
MAY - 6 1975
MISS. Bd. OF WATER COMM

If well telescopes please sketch and show depths.

GROUND LEVEL

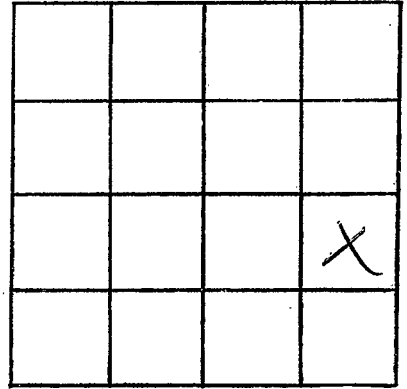

SECTION 12

Please indicate well location X.

ADDITIONAL INFORMATION

If more than one screen,
show locations of each on sketch.