

R 46  
 Meshoba  
 6/3/75

MISSISSIPPI  
 BOARD OF WATER COMMISSIONERS  
 416 North State Street  
 Jackson, Mississippi 39201

CODED

WATER WELL DRILLERS LOG

J. L. Conway MESHOBA

6-3-75 19 date well completed

J. L. Conway firm name

MESHOBA county well located

LANDOWNER:

Cook Ridge  
 R.R. 5 Church of God  
 Philadelphia Miss  
 (mailing address)

description of formations encountered

Red clay  
 Cal. sand  
 from 0 to 35  
 to 63

WELL LOCATION:

sec. 21 (N) 5 (S) R. 11 (E) 5 (W)  
 6 miles S of Wellsville  
 (distance) (direction) (nearest town)

WELL PURPOSE:

Church pastor  
 (home, irrigation, municipal, industrial)

WELL COMPLETION DATA:

- (1) diameter (inches) 9"
- (2) total depth (feet) 63'
- (3) static water level (feet) 20' below top of ground.
- (4) casing 2" P.V.C. 57' (material) (depth)  
 2" if telescope see back. (size)
- (5) screen 2" F.C. 63' (length) (depth to top)  
 2" F.C. P. (size) (material)
- (6) pump 1 (HP) 220 (yield gpm)  
 E.P.C. (type power)
- (7) electric log 40 (yes or no)

(organization running log)

(8) how well bottom plugged Cap.


DRILLERS REMARKS:

MISSISSIPPI  
 JUN 5 1975

MISS. RD. OF WATER COMMISSIONERS

If well telescopes please sketch and show depths.

GROUND LEVEL

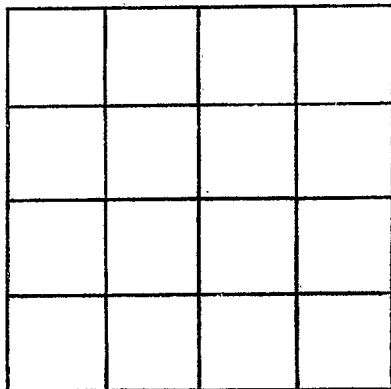

SECTION \_\_\_\_\_

Please indicate well location X.

ADDITIONAL INFORMATION

If more than one screen, show locations of each on sketch.