

Neshoba  
 R 47  
 7-14-75

MISSISSIPPI  
 BOARD OF WATER COMMISSIONERS  
 416 North State Street  
 Jackson, Mississippi 39201

WATER WELL DRILLERS LOG

7-19-75 19 F.D. Cannon NESHOPA  
 date well completed firm name county well located

LANDOWNER: Lige Strull

Description of formations encountered	from	to
<u>Red clay</u>	<u>0</u>	<u>63</u>
<u>Red clay</u>	<u>63</u>	<u>73</u>
<u>concrete and sand</u>	<u>73</u>	<u>91</u>
<u>concrete and sand</u>	<u>91</u>	<u>105</u>

(mailing address)

WELL LOCATION:  
 sec. 14 T10N R10E 13T  
7 miles S of Williamsville  
 (distance) (direction) (nearest town)

WELL PURPOSE:  
 (home) irrigation, municipal, industrial


- WELL COMPLETION DATA:
- (1) diameter (inches) 2"
  - (2) total depth (feet) 105
  - (3) static water level (feet) 60 below above top of ground.
  - (4) casing 2" PVC 98  
 (material) (depth)  
2" if telescope see back.  
 (size)
  - (5) screen 2" PVC 98  
 (length) (depth to top)  
2" PVC 6'  
 (size) (material)
  - (6) pump 1 220  
 (HP) (yield gpm)  
Elec.  
 (type power)
  - (7) electric log NO  
 (yes or no)  
CAF  
 (organization running log)
  - (8) how well bottom plugged

DISCOVERED  
 JUL 21 1975  
 MISS. BD. OF WATER COMMISSIONERS

DRILLERS REMARKS:

If well telescopes please sketch and show depths.

GROUND LEVEL

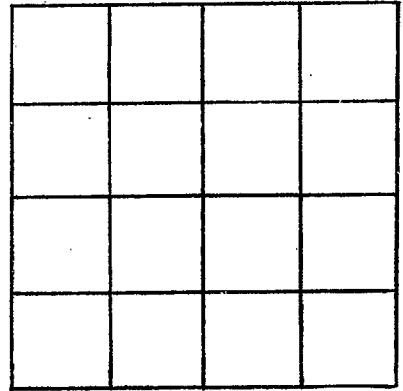

SECTION \_\_\_\_\_

Please indicate well location X.

ADDITIONAL INFORMATION

Lined area for additional information.

If more than one screen, show locations of each on sketch.