

NESHOPA
K 481
8-20-75

MISSISSIPPI
 BOARD OF WATER COMMISSIONERS
 416 North State Street
 137 Jackson, Mississippi 39201

WATER WELL DRILLERS LOG

8-20-75 1975 date well completed
 Common Drilling Service Neshoba firm name
 Neshoba county well located

LANDOWNER: Central Water Association
Philadelphia Miss
 (mailing address)

WELL LOCATION:
 sec. 30 T. 10 N R. 11 E
 S W
2 miles NE of Dixon
 (distance) (direction) (nearest town)

WELL PURPOSE: (home, irrigation, municipal, industrial)

WELL COMPLETION DATA:
 (1) diameter (inches) 10"
 (2) total depth (feet) 390
 (3) static water level (feet) 140 below above top of ground.
 (4) casing Steel 355
 (material) (depth)
 (size) if telescope see back.
 (5) screen 35 355
 (length) (depth to top)
6" Steel
 (size) (material)
 (6) pump 25 220
 (HP) (yield gpm)
Electric
 (type power)
 (7) electric log (yes or no)
 (organization running log)
 (8) how well bottom plugged Good

description of formations encountered	from	to
Clay	0	70
Sand & Silt	70	80
Clay & Rock	80	300
Clay & Sand		
bedges	300	350
Sand	350	390

DRILLERS REMARKS: No Skirting
Bill on Site
Promiscuously
Loggable

RECEIVED
 MAY 5 - 1977

MISS. DD. OF WATER COMM

7

If well telescopes please sketch and show depths.

GROUND LEVEL

672 Well 93 Well.
22" W Room. 672 Well
NS# 4-14.


313 →

353 →

390 →

If more than one screen, show locations of each on sketch.

2" cap pipe

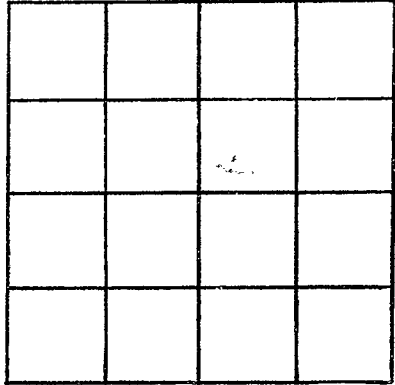

SECTION 30

Please indicate well location X.

ADDITIONAL INFORMATION

St. Paul Gas well
6" Marble 84/1
Horizontal Equal to
J. 10/14-5 Well.