

MISSISSIPPI DEPARTMENT OF NATURAL RESOURCES

Bureau of Land and Water Resources

Southport Mall

P.O. Box 10631

Jackson, Mississippi 39209

WATER WELL DRILLERS LOG

Coded

NESHOBA
K 50
12-12-90
MS-610-14569

12/12/90 19 T.M. PARKS DRILLING COMPANY NESHOBA
 date well completed firm name county well located

LANDOWNER: CENTRAL WATER ASSN. SOUTHWEST DIVISION	description of formations encountered.	from	to
P.O. BOX 33, PHILADELPHIA, MS (mailing address)	TOP SOIL.	0'	16'
WELL LOCATION: sec. <u>30</u> T. <u>10</u> N R. <u>11</u> E S W	RED SAND	16'	54'
6 miles SW of PHILADELPHIA (distance) (direction) (nearest town)	CLAYS, CHALK W/STREAKS	54'	170'
WELL PURPOSE: MUNICIPAL (home, irrigation, municipal, industrial)	SANDY SHALE	170'	185'
WELL COMPLETION DATA:	GUMBO & CLAYS	185'	200'
(1) diameter (inches) <u>12"</u>	SAND W/LOWER PART MIXED WITH LIGNITE	200'	260'
(2) total depth (feet) <u>360'</u>	SANDY CLAYS	260'	300'
(3) static water level (feet) <u>170' 5"</u> below top of ground.	SAND (GOOD)	300'	360'
(4) casing <u>STEEL</u> , <u>306'</u> (material) (depth)			
(5) screen <u>40'</u> , <u>310'</u> (length) (depth to top)			
<u>40' 85/8"</u> , <u>STEEL</u> (size) (material)			
(6) pump <u>50</u> , <u>500</u> (HP) (yield gpm)			
<u>3Ø</u> (type power)			
(7) electric log <u>YES</u> (yes or no)			
<u>USGS</u> (organization running log)			
(8) how well bottom plugged <u>BVP</u>			

(Reference Log # 46)

RECEIVED


DEC 26 1990

Department of Natural Resources
 Bureau of Land & Water

DRILLERS REMARKS:

If well telescopes please
sketch and show depths.

GROUND LEVEL

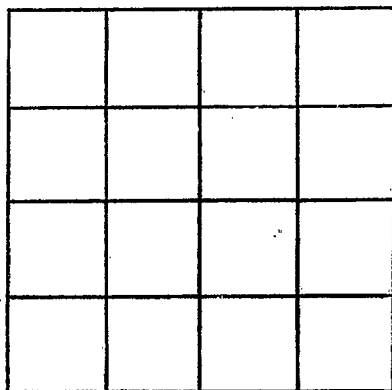

SECTION _____

Please indicate well location X.

ADDITIONAL INFORMATION

If more than one screen,
show locations of each on sketch.