

NESHOPA

R 2000

12-29-75

MISSISSIPPI BOARD OF WATER COMMISSIONERS

416 North State Street  
Jackson, Mississippi 39201

13T

WATER WELL DRILLERS LOG

Dec. 29 1975

Thomas & Son

Neshoba

date well completed

firm name

county well located

LANDOWNER: Don Turner

description of formations encountered

from

to

Rt. 9

Red Clay

0 10

Philadelphia, Miss.  
(mailing address)

Chalky Clay

10 18

Dirty Sand

18 40

Sand Rock & Chalk

40 52

5 ft yellow Chalk

52 65

& coarse Sand

WELL LOCATION:

sec. 19 T 10 N R 11 E W  
6 miles SW of Phila.  
(distance) (direction) (nearest town)

WELL PURPOSE:

(home, irrigation, municipal, industrial)

WELL COMPLETION DATA:

- (1) diameter (inches) 2
- (2) total depth (feet) 65
- (3) static water level (feet) 50 below above top of ground
- (4) casing PVC 60 (material) (depth)  
2 (size) if telescope see back.
- (5) screen 5 60 (length) (depth to top)  
2" 95/107 PVC (size) (material)
- (6) pump 3/4 6 (HP) (yield gpm)  
Ebe (type power)
- (7) electric log PVC (yes or no)

(organization running log)

(8) how well bottom plugged gravel


DRILLERS REMARKS:

RECEIVED  
MAR 8 1976

MISS. BD. OF WATER COMM

If well telescopes please sketch and show depths.

GROUND LEVEL

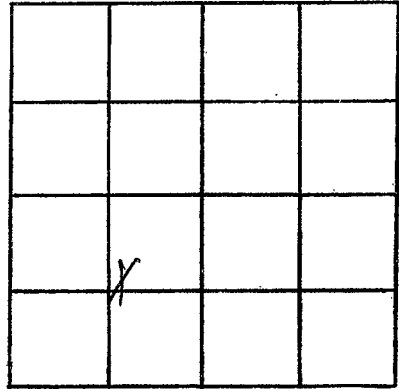

SECTION 19

Please indicate well location X.

ADDITIONAL INFORMATION

If more than one screen,  
show locations of each on sketch.