

NE SHOBA

K 2002

12/22/77

MISSISSIPPI BOARD OF WATER COMMISSIONERS  
416 North State Street  
Jackson, Mississippi 39201

WATER WELL DRILLERS LOG

12-22-77 date well completed

J.H. McDonald firm name

Weshoba county well located

LANDOWNER: Jim Therrall

Philadelphia miss

description of formations encountered

from

to

Red clay

0

20

Red sand clay  
yellow sand

20  
60

60  
65

(mailing address)

WELL LOCATION:

sec 8 T 10 N R 11 E

6 miles S.W. of Philadelphia

WELL PURPOSE: Home  
(home, irrigation, municipal, industrial)


WELL COMPLETION DATA:

- (1) diameter (inches) 2"
- (2) total depth (feet) 65
- (3) static water level (feet) 53 below top of ground
- (4) casing PVC 60 (material) (depth)  
2" (size) if telescope see back.
- (5) screen 5 65 60 (length) (depth to top)  
1/4 10 slot 55 (size) (material)
- (6) pump 1 4 (HP) (yield gpm)  
electric (type power)
- (7) electric log no (yes or no)

(organization running log)

(8) how well bottom plugged

DRILLERS REMARKS:

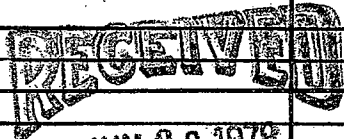


JUN 20 1978

MISS. BD. OF WATER COMMISSIONERS

If well telescopes please sketch and show depths.

GROUND LEVEL

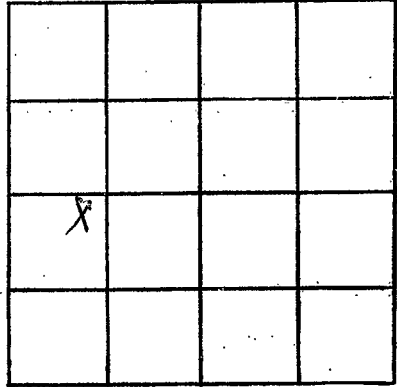

SECTION 8

Please indicate well location X.

ADDITIONAL INFORMATION

If more than one screen, show locations of each on sketch.