

MISSISSIPPI DEPARTMENT OF NATURAL RESOURCES

Bureau of Land and Water Resources

Southport Mall

P.O. Box 10631

Jackson, Mississippi 39209

WATER WELL DRILLERS LOG

NESTORA  
K2004

3-26 1986 Smith's well Drilling Neeshoba  
date well completed firm name county well located

LANDOWNER: DAVE Jainer

description of formations encountered

from to

Red sand	0	25
White sand	15	25
BIVE chalk	25	115
White Sand	115	135

(mailing address)

WELL LOCATION:

sec. 8 T. 10 N. R. 11 E  
6 miles SW of Phila.  
(distance) (direction) (nearest town)

WELL PURPOSE: HOME  
(home, irrigation, municipal, industrial)


WELL COMPLETION DATA:

- (1) diameter (inches) 2
- (2) total depth (feet) 135 FT
- (3) static water level (feet) 90 FT <sup>below</sup> <sub>above</sub> top of ground.
- (4) casing PVC 125 FT  
(material) (depth)  
(size) if telescope see back.
- (5) screen 10 FT 125 FT  
(length) (depth to top)  
2" PVC  
(size) (material)
- (6) pump 1 HP 8  
(HP) (yield gpm)  
E  
(type power)
- (7) electric log no  
(yes or no)

(organization running log)

(8) how well bottom plugged CAP


DRILLERS REMARKS:

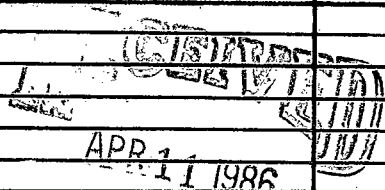

Department of Natural Resources  
Bureau of Land & Water Resources

If well telescopes please  
sketch and show depths.

GROUND LEVEL

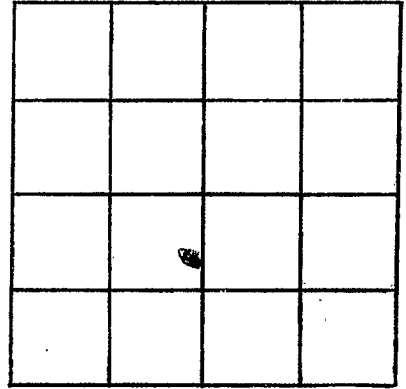

SECTION \_\_\_\_\_

Please indicate well location X.

ADDITIONAL INFORMATION

If more than one screen,  
show locations of each on sketch.