

3 131

Neshoba

L2

4-67

CODED

MISSISSIPPI
 BOARD OF WATER COMMISSIONERS
 416 North State Street
 Jackson, Mississippi 39201

WATER WELL DRILLERS LOG

April 6 1967 Ogletree Drilling Neshoba
 date well completed firm name county well located

LANDOWNER: James Holland

Rt. 9

Philadelphia, Miss.
(mailing address)

description of formations encountered

from to

White Chalk	0	15
Blue Chalk	15	75
White Sand	75	126

WELL LOCATION:

sec. 22 T 10 N R 12 E S W


4 miles South of Philadelphia
(distance) (direction) (nearest town)

WELL PURPOSE: Home use
(home, irrigation, municipal, industrial)

WELL COMPLETION DATA:

- (1) diameter (inches) 2"
- (2) total depth (feet) 126
- (3) static water level (feet) 28 below above top of ground.
- (4) casing Gav. 63
(material) (depth)
2" (size) if telescope see back.
- (5) screen None
(length) (depth to top)
(size) (material)
- (6) pump 1/2 6
(HP) (yield gpm)
Elec (type power)
- (7) electric log NO
(yes or no)
Ogletree Drilling
(organization running log)
- (8) how well bottom plugged Open


CODED

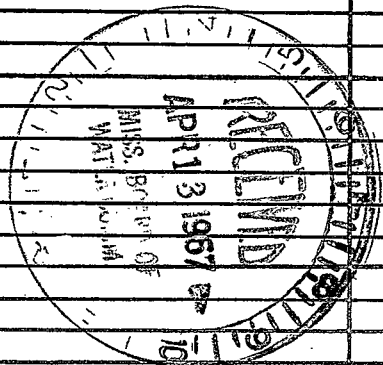

DRILLERS REMARKS:

If well telescopes please sketch and show depths.

GROUND LEVEL

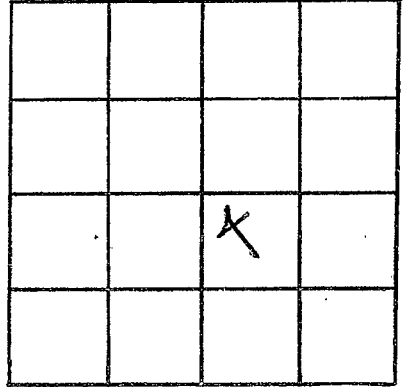

SECTION 22

Please indicate well location X.

ADDITIONAL INFORMATION

If more than one screen, show locations of each on sketch.