

5 137

Neshoba

L 3

6-67

MISSISSIPPI BOARD OF WATER COMMISSIONERS

416 North State Street
Jackson, Mississippi 39201

WATER WELL DRILLERS LOG

JUNE 22

19 67 OGLETREE DRILLING

NESHOPA

date well completed

firm name

county well located

LANDOWNER: HARDY LUNDY

description of formations encountered

from

to

RT. 1

RED CLAY

0 18

PHILADELPHIA, MISS.

BLUE CHALK

18 60

(mailing address)

GRAY SAND

60 78

WELL LOCATION:

sec. 2 T 10 N R 12 E
S W

3 1/2 miles EAST of PHILA.
(distance) (direction) (nearest town)

WELL PURPOSE: HOME USE
(home, irrigation, municipal, industrial)

WELL COMPLETION DATA:

(1) diameter (inches) 2"

(2) total depth (feet) 78

(3) static water level (feet) 25 below
top of ground. above

(4) casing Gav. 73
(material) (depth)

(size) if telescope see back.

(5) screen 5 73
(length) (depth to top)

1 1/4 Stainless Steel
(size) (material)

(6) pump 1/2 5.5
(HP) (yield gpm)

ELECTRIC
(type power)


(7) electric log NO
(yes or no)

(organization running log)

(8) how well bottom plugged

DRILLERS REMARKS:

CODED

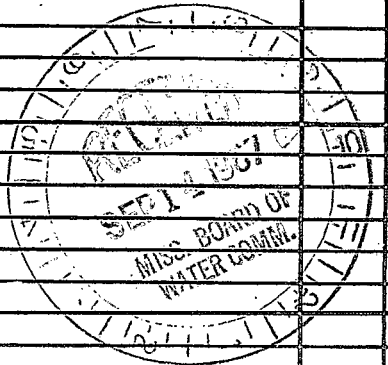

If well telescopes please sketch and show depths.

GROUND LEVEL

X			

SECTION 2

Please indicate well location X.

ADDITIONAL INFORMATION

If more than one screen, show locations of each on sketch.