

3 13T

Neshoba

CODED

7-67

MISSISSIPPI BOARD OF WATER COMMISSIONERS  
416 North State Street  
Jackson, Mississippi 39201

WATER WELL DRILLERS LOG

JULY 19 19 67 OGLETREE DRILLING NESHORA  
date well completed firm name county well located

LANDOWNER: LEWIS RAY BARRETT

description of formations encountered	from	to
RED CLAY	0	20
BLUE CHALK	20	88
GRAY SAND	88	110

RT. 1 PHILADELPHIA, MISS.

(mailing address)

WELL LOCATION:


sec. 9 T 10 N R 12 E  
S W  
4 miles South of Phila.  
(distance) (direction) (nearest town)

WELL PURPOSE: Home Use  
(home, irrigation, municipal, industrial)

WELL COMPLETION DATA:

- (1) diameter (inches) 2"
- (2) total depth (feet) 110
- (3) static water level (feet) 57 below above top of ground.
- (4) casing Galv. 105 (material) (depth)  
(size) if telescope see back.
- (5) screen 5 110 (length) (depth to top)  
1 1/2 Stainless Steel (size) (material)
- (6) pump 3/4 5 (HP) (yield gpm)  
BEA (type power)
- (7) electric log NO (yes or no)  
(organization running log)
- (8) how well bottom plugged POINT AND PLUG


CODED

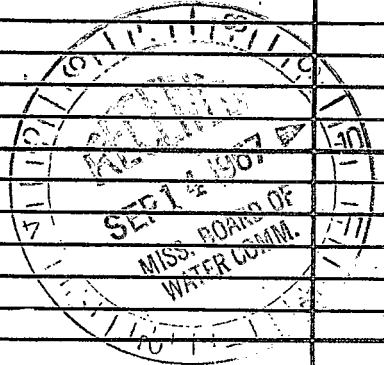

DRILLERS REMARKS:

If well telescopes please sketch and show depths.

GROUND LEVEL

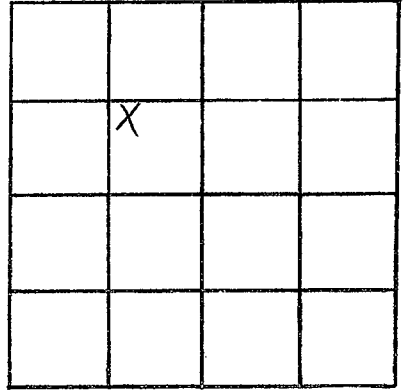

SECTION 9

Please indicate well location X.

ADDITIONAL INFORMATION

If more than one screen, show locations of each on sketch.