

NEShoBA  
 L5  
 1-68 EODED

MISSISSIPPI  
 BOARD OF WATER COMMISSIONERS  
 416 North State Street  
 Jackson, Mississippi 39201

WATER WELL DRILLERS LOG

January 20 1968 Beck Smith Neshoba  
 date well completed firm name county well located  
 Phila miss


LANDOWNER:	description of formations encountered	from	to
Gulard Peirce Phila, miss (mailing address)			
	Mix blue dirt	15	390
	Went through rock the white coarse sand	290	315
WELL LOCATION:			
sec. 12 T 10 N R 12 E S W			
12 miles SE of Phila (distance) (direction) (nearest town)			
WELL PURPOSE: home (home, irrigation, municipal, industrial)			
WELL COMPLETION DATA:			
(1) diameter (inches) 2			
(2) total depth (feet) 315'			
(3) static water level (feet) 130 below above top of ground.			
(4) casing Galv. 315' (material) (depth)			
(size) If telescope see back.			
(5) screen 5' 310 (length) (depth to top)			
008 Stainless steel (size) (material)			
(6) pump 1 1/2 HP get (HP) (yield gpm)			
elect. (type power)			
(7) electric log no (yes or no)			
(organization running log)			
(8) how well bottom plugged. back wash salt			
DRILLERS REMARKS:			

EODED



If well telescopes please sketch and show depths.

GROUND LEVEL

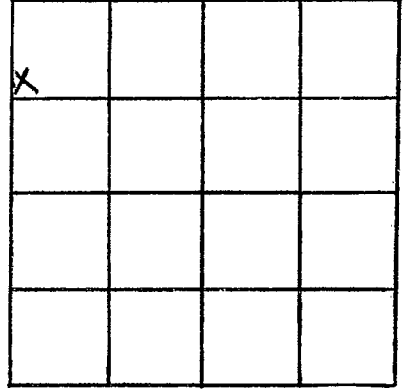

SECTION \_\_\_\_\_

Please indicate well location X.

ADDITIONAL INFORMATION

If more than one screen, show locations of each on sketch.