

L 9

CODED

WATER WELL DRILLERS LOG

12-8-60

2301

Date: 12-8, 1960, Driller: TSM

County: Neshoba

(Name)

(1) Owner of Land: [Handwritten Name]

(Name)

[Handwritten Address]

(Address)

(2) Location: 1/4, 1/4, Sec. 16, T10R12

10 miles SE of [Handwritten Town]

(distance)

(direction)

(Nearest Town)

(3) Topography: [Handwritten]

(Hilly)

(Flat)

(Level)

(4) Purpose of Well: [Handwritten]

(Domestic Irrigation, Municipal, Industrial, Other)

Description & Color of Materials
Sand, Clay, Red Clay, Shell, etc.

Thick-
ness-
Feet

Depth
Feet

[Handwritten]	12	
[Handwritten]	15	
[Handwritten]	14	
[Handwritten]	15	
[Handwritten]	7	165

CODED

Information upon completion of well:

(1) Diameter 2 inches.

(2) Total Depth 165 feet.

(3) Water Level 75 feet below top of ground.

(4) Cased to 64, Size 2

(5) Screen: Size, Length

(6) Were any formations sealed against pollution?


yes, no.

If YES depth of formation

Why

Drillers Remarks:

CODED

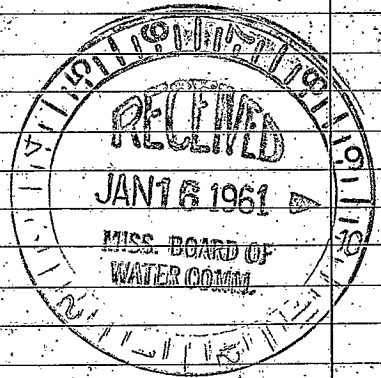

(Use Back Side)

Well No.

