

L 11  
2-15-62

5 187  
CODED WATER WELL DRILLERS LOG

Date: 2-15, 1962, Driller: Marshall R. ... County: ...  
(Name)

(1) Owner of Land: Paul Sparks  
(Name)  
Rt 1 Philadelphia Miss  
(Address)  
(2) Location: 1/4, 1/4, Sec. 2 T. 12 R. 12  
7 miles E of Philadelphia  
(distance) (direction) (Nearest Town)  
(3) Topography: X  
(Hilly) (Flat) (Level)  
(4) Purpose of Well: D  
(Domestic Irrigation  
Municipal, Industrial, Other)

Description & Color of Materials Sand, Clay, Red Clay, Shell, etc.	Thick- ness Feet	Depth Feet
Red Clay	12	
Red Sand	12	52
Dark Chalk	52	78
White Sand	78	83

PS A BREDA  
Hole was Drilled  
To 100 Feet  
Dark Chalk. 83 160  
Was not used


Information upon completion of well:

(1) Diameter 2 inches.  
(2) Total Depth 83 feet.  
(3) Water Level 45 feet below top of ground.  
(4) Cased to 78, Size 2  
(5) Screen: Size 2, Length 5  
(6) Were any formations sealed against pollution?  
\_\_\_\_ yes, \_\_\_\_ no.

If YES depth of formation \_\_\_\_\_  
Why \_\_\_\_\_  
Drillers Remarks: \_\_\_\_\_

CODED

CODED

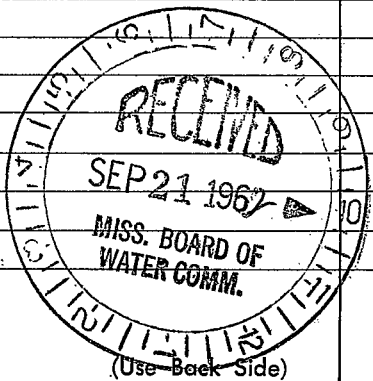

Well No.

