

L12

6 137

Shelby  
S. T. 10 R. 4  
2-68

MISSISSIPPI  
BOARD OF WATER COMMISSIONERS  
416 North State Street  
Jackson, Mississippi 39201

WATER WELL DRILLERS LOG

date well completed 3-15-68 M. L. Ray Shelby  
from name M. L. Ray county well located

LANDOWNER: Hanner Clark  
Philadelphie  
Miss R # 4  
(mailing address)

description of formations encountered  
from to

WELL LOCATION:  
sec. 7 T. 10 N. 12 E  
4 miles S of Phillips  
(distance) (direction) (nearest town)

blue clay  
to 40 ft sand  
to 50 ft  
clay at bottom

WELL PURPOSE: home water  
(home, irrigation, municipal, industrial)

WELL COMPLETION DATA:  
(1) diameter (inches) 2 in  
(2) total depth (feet) 100 ft  
(3) static water level (feet) 5 ft below top of ground.  
(4) casing 70 ft (material) 100 ft (depth)

stone to go  
sealed casing  
at 70 ft  
sand level  
to 100 ft

(size) if telescope see back.

(5) screen none  
(length) (depth to top)


(6) pump 1/2 HP 7.9 gpm  
(HP) (yield gpm)  
elec  
(type power)

(7) electric log no  
(yes or no)  
Casualty Co. a firm well  
(organization running log)

(8) how well bottom plugged yes

DRILLERS REMARKS:

CODED  
CODED

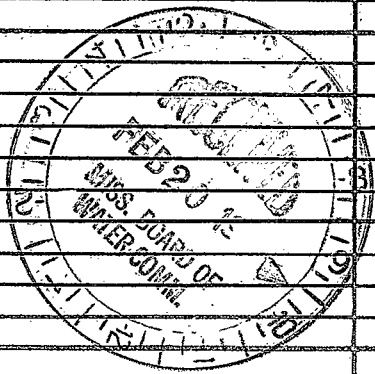

If well telescopes please sketch and show depths.

GROUND LEVEL

*Handwritten notes in the left column, including "11 0 0 0" and "10 10 0 0".*

|           |          |           |           |
|-----------|----------|-----------|-----------|
| <i>12</i> | <i>1</i> |           |           |
| <i>10</i> | <i>1</i> | <i>10</i> | <i>10</i> |
| <i>10</i> | <i>1</i> |           |           |
| <i>10</i> | <i>1</i> | <i>10</i> | <i>10</i> |

SECTION 7

Please indicate well location X.

ADDITIONAL INFORMATION

*Handwritten notes in the right column, including "1000", "1000", and "1000".*

If more than one screen, show locations of each on sketch.