

NESHOBA

L13

9-13-74

MISSISSIPPI BOARD OF WATER COMMISSIONERS
416 North State Street
Jackson, Mississippi 39201

CODED

WATER WELL DRILLERS LOG

9-13-74
date well completed

Oglethorpe Drilling Co. Neshoba
firm name

county well located

LANDOWNER Joseph Mc Closkey
Joseph Mc Closkey
Rt 4
(mailing address)

description of formations encountered		from	to
Chalk		0	16
Blue clay		16	148
mud		148	163
Blue clay		163	314
Shell pt		314	585
Clay clay		585	422
water sand		422	462

WELL LOCATION:
sec. 14 T. 10 N R. 12 E
7 miles South of P. Hills.
(distance) (direction) (nearest town)

WELL PURPOSE:
(home, irrigation, municipal, industrial)

- WELL COMPLETION DATA:
- (1) diameter (inches) 2"
 - (2) total depth (feet) 462
 - (3) static water level (feet) 130 below top of ground.
 - (4) casing galv. 2 7/8" (material), 274 (depth), 2" (size) if telescope see back.
 - (5) screen (length) (depth to top)
 - (6) pump 1 1/2 (HP), 8 (yield gpm), RE 17 (type power)
 - (7) electric log (yes or no)
 - (organization running log)
 - (8) how well bottom plugged open


RECEIVED
SEP 30 1974

DRILLERS REMARKS:

MISS. BD. OF WATER COMMISSIONERS

If well telescopes please sketch and show depths.

GROUND LEVEL

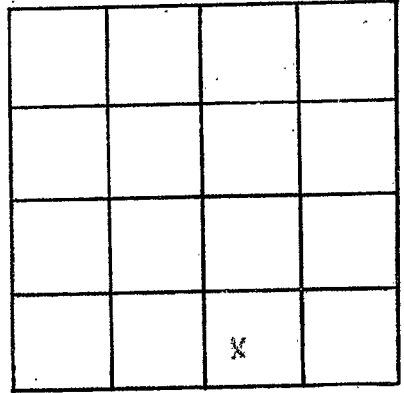

SECTION _____

Please indicate well location X.

ADDITIONAL INFORMATION

If more than one screen,
show locations of each on sketch.