

BL15

5 13T

4-15-62 CODED

WATER WELL DRILLERS LOG

Date: 4-15, 1962 Driller: M. S. Ray County: Neshoba

(Name)

(1) Owner of Land: P. H. Jordan
(Name)
Ph... R.H. 4
(Address)

(2) Location: 1/4, 1/4 Sec. 10, 12 T. R.
1 miles south of...
(distance) (direction) (Nearest Town)

(3) Topography: (Hilly) (Flat) (Level)

(4) Purpose of Well: Domestic Irrigation
(Domestic Irrigation, Municipal, Industrial, Other)

Description & Color of Materials Sand, Clay, Red Clay, Shell, etc.	Thick- ness Feet	Depth Feet
Sand to 2 ft		
blue sand		
2 ft - 10 ft		
1/2 ft. sand		
red clay at 25		
at 25 ft		
at 25 ft		

Information upon completion of well:

(1) Diameter 2 inches.

(2) Total Depth 84 feet.

(3) Water Level 30 feet below top of ground.

(4) Cased to 100, Size 2

(5) Screen: Size, Length

(6) Were any formations sealed against pollution?


yes, no.

If YES depth of formation

Why concrete seal water

Drillers Remarks: at 20 ft

CODED

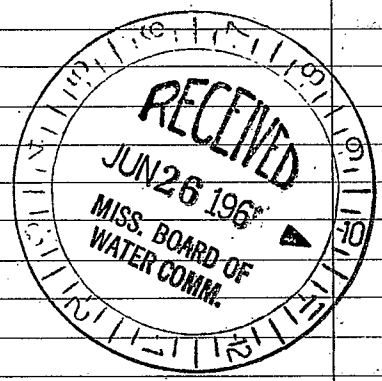

(Use Back Side)

Well No.

