

NESTROBA

WATER WELL DRILLERS LOG

6 L16

6 131

Date: June 8, 1964, Driller: Mag Ray County Nestoba

6-8-64

(Name)

(1) Owner of Land: Johnnie Wells
 (Name)
Phila R# 4
 (Address) S-10-12

(2) Location: 1/4, 1/4, Sec. 26 T R
2 miles East of Phila
 (distance) (direction) (Nearest Town)

(3) Topography: (Hilly) (Flat) (Level)

(4) Purpose of Well: Domestic
 (Domestic Irrigation, Municipal, Industrial, Other)

Description & Color of Materials Sand, Clay, Red Clay, Shell, etc.	Thick- ness Feet	Depth Feet
<u>Red Clay to 12 ft</u>		
<u>Shell Rock on</u>		
<u>flatter ground</u>		
<u>to 25 ft Blue</u>		
<u>soap stone to 100 ft</u>		
<u>sand 135 - 145 ft</u>		

Information upon completion of well:

(1) Diameter 2 inches.

(2) Total Depth 147 feet.

(3) Water Level 50 feet below top of ground.

(4) Cased to 8 1/4, Size 2 in

(5) Screen: Size none Length _____


(6) Were any formations sealed against pollution?
 yes, no.

If YES depth of formation 76 ft

Why: flatter place in part

Drillers Remarks: _____

CODED

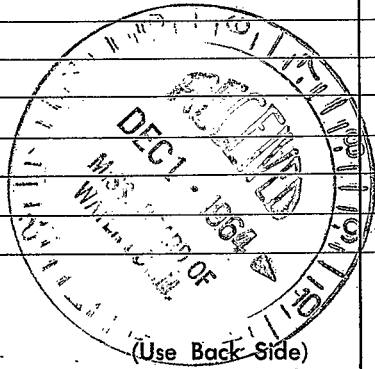

Well No.

