

NEHOBA

CODED WATER WELL DRILLER

6417

6 137

Date: June 14 1964 Driller: M. G. Gray County Neshoba

6-14-64

(Name)

(1) Owner of Land:	Description & Color of Materials Sand, Clay, Red Clay, Shell, etc.	Thick- ness Feet	Depth Feet
(Name) <u>Lishey Sharp</u> (Address) <u>Philomiss R#4</u> <u>34-10-12</u>	<u>Red Clay to 15 ft</u>		<u>Sand from 15-70 ft</u>
(2) Location: <u>1/4</u> , <u>1/4</u> , Sec. <u>T</u> <u>R</u> <u>7</u> miles <u>East</u> of <u>Phil</u> (distance) (direction) (Nearest Town)			
(3) Topography: <input checked="" type="checkbox"/> (Hilly) <input type="checkbox"/> (Flat) <input type="checkbox"/> (Level)			
(4) Purpose of Well: <u>Domestic</u> (Domestic Irrigation Municipal, Industrial, Other)			

Information upon completion of well:


- (1) Diameter 2 inches.
- (2) Total Depth 70 feet.
- (3) Water Level 30 feet below top of ground.
- (4) Cased to 63, Size 2 in
- (5) Screen: Size 60, Length 6 ft
- (6) Were any formations sealed against pollution?
 yes, no.

If YES depth of formation _____

Why _____

Drillers Remarks: _____

CODED

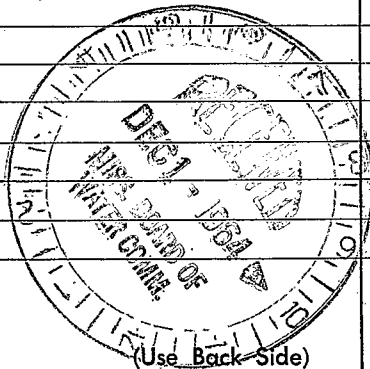

(Use Back Side)

Well No.

