

Neshoba
L 20
9-5-71

CODED

MISSISSIPPI
BOARD OF WATER COMMISSIONERS
416 North State Street
Jackson, Mississippi 39201

FEB 18 1972

WATER WELL DRILLERS LOG

MISS. BD. OF
W.

9-5-71 19 BeCK SMITH NESHoba
date well completed firm name county well located

LANDOWNER:

SAM CUMBERLAND
PHILA. MISS
(mailing address)

description of formations encountered

from to

red clay	0	20
blue chalk	20	30
gray sand	30	40

WELL LOCATION:

sec. 1 T. 10 N R. 12 E
B miles S of PHILA
(distance) (direction) (nearest town)

WELL PURPOSE: HOME
(home, irrigation, municipal, industrial)

WELL COMPLETION DATA:

- (1) diameter (inches) 2"
- (2) total depth (feet) 40'
- (3) static water level (feet) 20' ^{below} _{above} top of ground.
- (4) casing galv., 35'
(material) (depth)
2"
(size) If telescope see back.
- (5) screen 5', 35'
(length) (depth to top)
008, STAINLESS STEEL
(size) (material)
- (6) pump 1/2 6
(HP) (yield gpm)
ELEC
(type power)
- (7) electric log NO
(yes or no)

CODED


(organization running log)

(8) how well bottom plugged BACK
WASH VALUE

DRILLERS REMARKS:

If well telescopes please sketch and show depths.

GROUND LEVEL

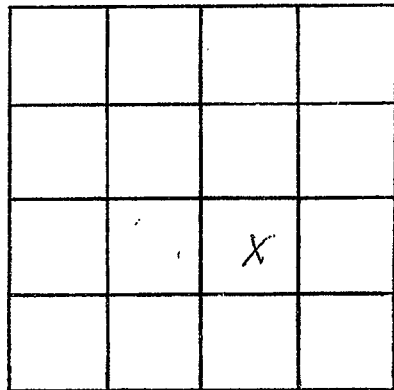

SECTION 1

Please indicate well location X.

ADDITIONAL INFORMATION

If more than one screen, show locations of each on sketch.