

Neshoba
L21
1-8-72

CODED
MISSISSIPPI
BOARD OF WATER COMMISSIONERS
416 North State Street
Jackson, Mississippi 39201

FEB 18 1972

WATER WELL DRILLERS LOG

1-8-72 19 Beck Smith Neshoba
date well completed firm name county well located

LANDOWNER:
Willard Posey
Phila Miss
(mailing address)

description of formations encountered	from	to
	<u>red clay</u>	<u>0</u>
<u>black chalk</u>	<u>55</u>	<u>80</u>
<u>gray sand</u>	<u>80</u>	<u>105</u>

WELL LOCATION:
sec. 1 T. 10 N. R. 12 E.
12 miles S of Phila
(distance) (direction) (nearest town)

WELL PURPOSE:
(home, irrigation, municipal, industrial)

WELL COMPLETION DATA:

(1) diameter (inches) 2"

(2) total depth (feet) 105'

(3) static water level (feet) 40 (below above) top of ground.

(4) casing galv, 100'
(material) (depth)
2"
(size) If telescope see back.

(5) screen 5', 100'
(length) (depth to top)
008, stainless steel
(size) (material)

(6) pump 1 HP
(HP) (yield gpm)
ele
(type power)

(7) electric log no
(yes or no)

(organization running log)


CODED

(8) how well bottom plugged back
wash valve

DRILLERS REMARKS:

If well telescopes please sketch and show depths.

GROUND LEVEL

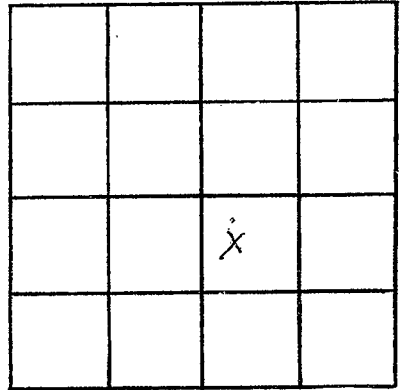

SECTION 1

Please indicate well location X.

ADDITIONAL INFORMATION

If more than one screen,
show locations of each on sketch.