

MISSISSIPPI  
BOARD OF WATER COMMISSIONERS  
416 North State Street  
Jackson, Mississippi 39201

WATER WELL DRILLERS LOG

Neshoba  
L 25  
4-7-70

4-7 1970 Beck Smith Neshoba  
date well completed firm name county well located

LANDOWNER: ALLEN HENRIK  
Rt 1  
Phila, Miss  
(mailing address)

description of formations encountered	from	to
	<u>Red CLAY</u>	<u>0</u>
<u>Blue CHALK</u>	<u>70</u>	<u>100</u>
<u>GRAY SAND</u>	<u>100</u>	<u>110</u>

WELL LOCATION:  
sec I T 10 R 13 E 202  
5 miles E of Phila  
(distance) (direction) (nearest town)

WELL PURPOSE: home  
(home, irrigation, municipal, industrial)

WELL COMPLETION DATA:

- (1) diameter (inches) 2
- (2) total depth (feet) 110
- (3) static water level (feet) 40 below above top of ground.
- (4) casing galv, 105,  
(material) (depth)  
5 If telescope see back.  
(size)
- (5) screen 5, 105  
(length) (depth to top)  
008, STAINLESS STEEL  
(size) (material)
- (6) pump 1 HP  
(HP) (yield gpm)  
elec  
(type power)
- (7) electric log \_\_\_\_\_  
(yes or no)  
\_\_\_\_\_  
(organization running log)
- (8) how well bottom plugged back  
Wash Water


DRILLERS REMARKS:

MAY 8 1970

MISS. BD. OF  
WATER COMM.

If well telescopes please sketch and show depths.

GROUND LEVEL

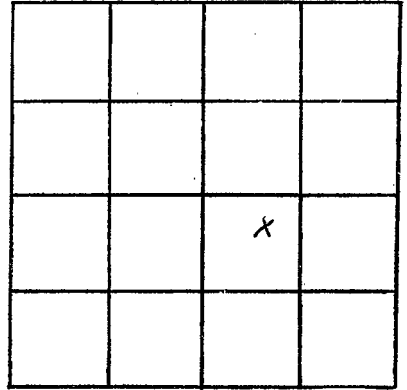

SECTION 1

Please indicate well location X.

ADDITIONAL INFORMATION

If more than one screen,  
show locations of each on sketch.