


If well telescopes please sketch and show depths.

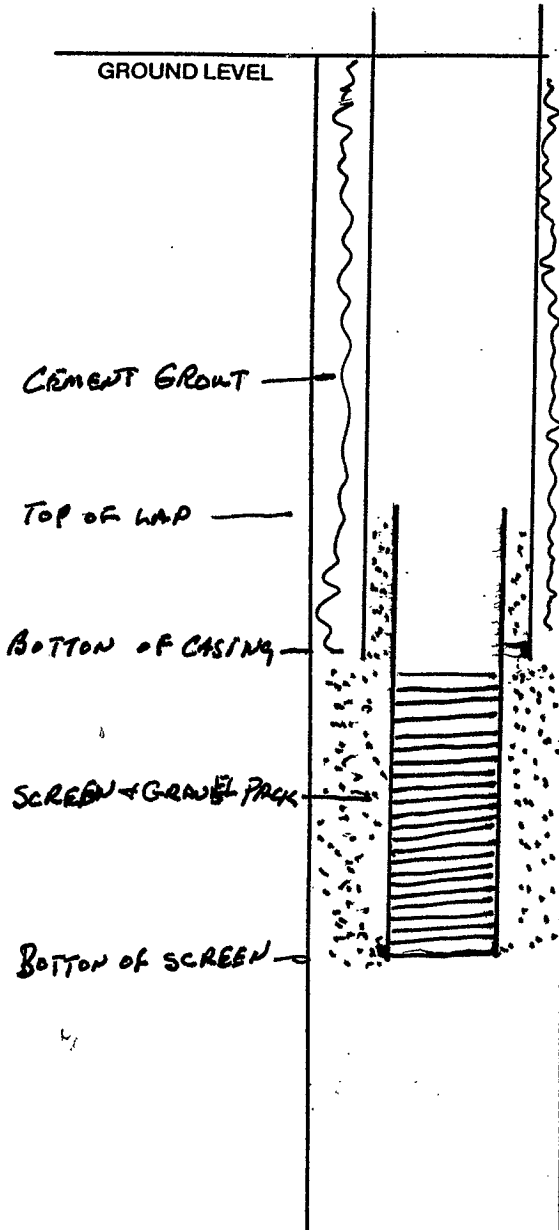

If more than one screen, show location of each on sketch.

SECTION _____

Please indicate well location X.

Pump Capacity (GPM)	No. of Stages	Setting Depth
700	5	320 FT.
PUMP TEST		
Well yielded <u>703</u> GPM with a drawdown of <u>26.65</u> ft. after <u>25</u> hours of pumping		

LOG DATA

TYPE OF LOG RUN (Circle One): Electric, Gamma Ray, Density, Sonic, Neutron, Other (Describe) _____

Name of Organization Running Log
MISSISSIPPI OFFICE OF GEOLOGY

GEOLOGIC DATA (Office Use Only)

Surface Elev.	Geologic Unit	Unit Thickness	Depth to Top
Subs. SWL	Date	Analysis	Aquifer Test

Driller's Remarks

WLCXL aquifer