

**MISSISSIPPI  
BOARD OF WATER COMMISSIONERS**  
416 North State Street  
Jackson, Mississippi 39201

**WATER WELL DRILLERS LOG**

Weshaba  
L-200B  
9/20/77

9-20-77 19 Williamson Drilling Co. Weshaba  
date well completed firm name county well located

LANDOWNER: Bern Gibson  
Spinner Job  
Philadelphia, Miss.  
(mailing address)

WELL LOCATION:  
sec. 25 T-10N R-12E  
S W  
7 miles S.E. of Phill.  
(distance) (direction) (nearest town)

WELL PURPOSE:  
(home, irrigation, municipal, industrial)


- WELL COMPLETION DATA:
- (1) diameter (inches) 4
  - (2) total depth (feet) 433
  - (3) static water level (feet) 220 <sup>below</sup>/<sub>above</sub> top of ground.
  - (4) casing PVC, 255,  
(material) (depth)  
4 If telescope see back.  
(size)
  - (5) screen No,  
(length) (depth to top)  
(size) (material)
  - (6) pump 3/4, 7  
(HP) (yield gpm)  
Shot  
(type power)
  - (7) electric log No  
(yes or no)  
No  
(organization running log)
  - (8) how well bottom plugged open

description of formations encountered	from	to
<u>top soil</u>	<u>0</u>	<u>3</u>
<u>red clay</u>	<u>3</u>	<u>12</u>
<u>red soil</u>	<u>12</u>	<u>25</u>
<u>blue clay</u>	<u>25</u>	<u>80</u>
<u>sand</u>	<u>80</u>	<u>120</u>
<u>black clay</u>	<u>120</u>	<u>270</u>
<u>red + clay</u>	<u>270</u>	<u>310</u>
<u>blue clay</u>	<u>310</u>	<u>390</u>
<u>sand</u>	<u>390</u>	<u>433</u>

DRILLERS REMARKS:

If well telescopes please sketch and show depths.

GROUND LEVEL

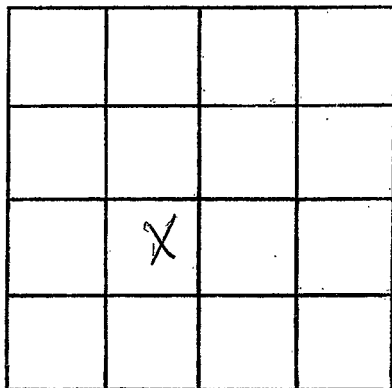

SECTION 15

Please indicate well location X.

ADDITIONAL INFORMATION

If more than one screen, show locations of each on sketch.